

20-7-21 *Paul P*

TYPE

AFFIDAVIT OF COMPLETION FORM

ACO-1 WELL HISTORY

SIDE ONE



Two (2) copies of this form shall be filed with the Kansas Corporation Commission, 200 Colorado Derby Building, Wichita, Kansas 67202, within thirty (30) days after the completion of a well, regardless of how the well was completed.

Attach separate letter of request if the information is to be held confidential. If confidential, only file one copy. Information on Side One will be of public record and Side Two will then be held confidential.

Applications must be made on dual completion, commingling, salt water disposal, injection and temporarily abandoned wells.

Attach one copy only wireline logs (i.e. electrical log, sonic log, gamma ray neutron log, etc.). (Rules 82-2-105 & 82-2-125) KCC# (316) 263-3238.

LICENSE # 7211 EXPIRATION DATE 6-30-83

OPERATOR L & A Oil Company API NO. 15-065-21720

ADDRESS Box 204 COUNTY Graham

Bogue, KS 67625 FIELD \_\_\_\_\_

\*\* CONTACT PERSON Leon Stephen PROD. FORMATION \_\_\_\_\_  
PHONE 913-674-5650

PURCHASER \_\_\_\_\_ LEASE Stephen

ADDRESS \_\_\_\_\_ WELL NO. #1

DRILLING John O. Farmer, Inc. WELL LOCATION W/2 NW SW

CONTRACTOR \_\_\_\_\_ 660 Ft. from the north Line and

ADDRESS P.O. Box 352 330 Ft. from the west Line of

Russell, KS 67665 the SW/4(Qtr.) SEC 20 TWP 7S RGE 21W.

PLUGGING John O. Farmer, Inc. WELL PLAT \_\_\_\_\_ (Office Use Only)

CONTRACTOR \_\_\_\_\_

ADDRESS P.O. Box 352

Russell, KS 67665

TOTAL DEPTH 3720' PBTD \_\_\_\_\_

SPUD DATE 11-8-82 DATE COMPLETED 11-16-82

ELEV: GR 2100' DF 2103' KB 2105'

DRILLED WITH ~~WABIXX~~ (ROTARY) ~~WABIXX~~ TOOLS.

DOCKET NO. OF DISPOSAL OR REPRESSURING WELL BEING USED TO DISPOSE OF WATER FROM THIS LEASE \_\_\_\_\_

Amount of surface pipe set and cemented 210' DV Tool Used? No


THIS AFFIDAVIT APPLIES TO: (Circle ONE) - Oil, Gas, Shut-in Gas, Dry, Disposal, Injection, Temporarily Abandoned, OWWO. Other \_\_\_\_\_

ALL REQUIREMENTS OF THE STATUTES, RULES AND REGULATIONS PROMULGATED TO REGULATE THE OIL AND GAS INDUSTRY HAVE BEEN FULLY COMPLIED WITH.

AFFIDAVIT

Leon Stephen President, being of lawful age, hereby certifies that:

I am the Affiant, and I am familiar with the contents of the foregoing Affidavit. The statements and allegations contained therein are true and correct.

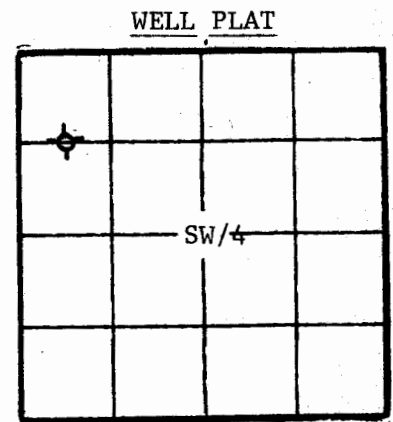

(Office Use Only)  
KCC \_\_\_\_\_  
KGS   
SWD/REP \_\_\_\_\_  
PLG. \_\_\_\_\_

State Geological Survey  
WICHITA BRANCH

*Paul P*

SIDE TWO

ACO-1 WELL HISTORY

OPERATOR L & A Oil Company LEASE Stephen # | SEC. 20 TWP. 7S RGE. 21W

FILL IN WELL LOG AS REQUIRED:

Show all important zones of porosity and contents thereof; cored intervals, and all drill-stem tests, including depth interval tested, cushion used, time tool open, flowing and shut-in pressures, and recoveries.

SHOW GEOLOGICAL MARKERS, LOGS RUN, OR OTHER DESCRIPTIVE INFORMATION.

FORMATION DESCRIPTION, CONTENTS, ETC.	TOP	BOTTOM	NAME	DEPTH
Shale & Sand	0	216		
Sand & Shale	216	1210		
Sand	1210	1400		
Red Bed	1400	1678		
Anhydrite	1678	1712		
Shale & Shells	1712	1875		
Shale	1875	2175		
Shale & Shells	2175	2450		
Shale & Lime	2450	3035		
Lime	3035	3180		
Shale & Lime	3180	3335		
Lime	3335	3720		
DST #1 3333-3365 20-30-20-30 Strong blow in 1 minute. 1st open				
2nd open strong blow recovered 1980 Ft of salt watery mud.				
FIP 712# IOP 1302# SFLP 1057# FOP 1263#				
DST #2 3179-3545 30-30-10-0 1st open weak blow 2nd open so blow				
FIP 69# IOP 621# SFLP 69# FOP 0# Recovered 2 feet of watery mud				
DST #3 Packer failure				
DST #4 3507-3635 1st open weak blow 30-45-60-90 2nd open very weak				
FIP 67# IOP 763# SFLP 78# FOP 730# Recovered 90 Feet of Salt				
watery mud.				

Report of all strings set — surface, intermediate, production, etc. **CASING RECORD** (New) or (Used)

Purpose of string	Size hole drilled	Size casing set (in O.D.)	Weight lbs/ft.	Setting depth	Type cement	Sacks	Type and percent additives
Surface	12-1/4"	8-5/8"	24	216'	Common	160	3% C.C., 2% gel

**LINER RECORD**

**PERFORATION RECORD**

Top, ft.	Bottom, ft.	Sacks cement	Shots per ft.	Size & type	Depth interval

<b>TUBING RECORD</b>		
Size	Setting depth	Packer set at