
DX 78-1

Graham KANSAS

Section 21 Township 7 Range 25 W

Well No. #2 Blazier

Company CSO & Colo. O&G

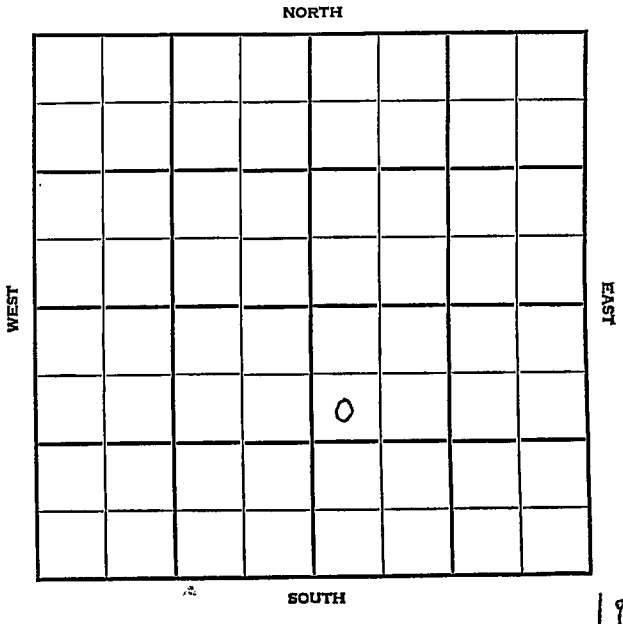


10

HOT FILE Graham KANSAS

| SEC. | TWP. | R. |
|---|---|---|
| 21 | 7 | 25 W |

WELL NO.

# 2 Blazier FARM

COMPANY

CSO & Colo. O & G

CONTRACTOR

Glenn Peel


Blazier

_____ Ft. from N. Line

_____ Ft. from S. Line

_____ Ft. from E. Line

_____ Ft. from W. Line

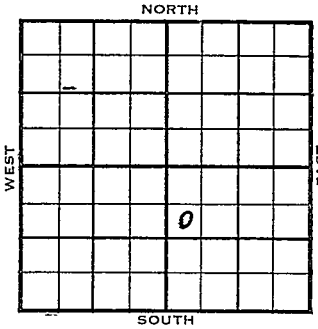


SW NW SE

1/2 Mile - SDX Lse

| 1955 | ELEVATION REPORT |
|---|---|
| 8/24 | MIR |
| 9-1 | Spud 8-24-55,<br>8 5/8" @ 238/225,<br>Top. 3434, Heeb. 3633,<br>Drlg. 3640' |
| 9-8 | Dodge 3654, Lans. 3671, BKC 3881<br>DST 3700-08, open 1 hr., rec. 1140' socsw, 1300#<br>DST 3734-59, open 1 hr., gas to surface in 1 hr., rec. 1270' gassy muddy oil, 1200#,<br>DST 3785-3812, open 1 hr., rec 280' oil 540'mco, 180' gassy muddy oil, 1210#,<br>DST 3819-45, open 1 hr.,rec. 340' hmc gassy oil, 1265#,<br>DST 3849-90, open ½ hr., rec. 6' mud, 0#, 5½" @ 3890 |
| 9-15 | CO to 3875, 41/ 3800-10, B/ 120 go 15hr 1000 A, P/ 393 bo 24 hr., Bomb test 884 bo 24 hr. |
| 9-22 | Gravity 40.9 |
| 9-29 | No report |
| 10-6 | No report |
| 10-13 | " " |

OVER

DX-78

1955

10/19 Comm 8-24-55
8 5/8" @ 238/225

| | |
|---|---|
| Tp | 3434 |
| H | 3633 |
| Dodge | 3654 |
| L | 3671 |
| BKC | 3881 |
| TD | 3890 |

DST 3700-08 open 1 hr Rec 1140' socsw 1300# DST 3734-59 open 1 hr gas to surf. in 1 hr Rec 1270' gassy muddy oil 1200# DST 3785-3812 open 1 hr Rec 280' oil 540' mco 180' muddy gassy oil, 1210# DST 3819-45 open 1 hr Rec 340' hmcgo 1265# DST 3849-90 open 1/2 hr rec 6' mud 0# 5 1/2" @ 3890 CO to 3875 41/3800-10 B/120 go 16 hr 1000 A P/393 bo 24 hr BHB 884 bo 24 hr Comp P/243 bopd

COMPLETED

FORM 513 REV. SUNRAY

County Graham Elev.

Sec. 22 Twp. 7 Rge. 25W

Company CSO & Colo. O & G

Farm Name Blagier No. 2

| TOPS | DEPTH | LOG | DATUM |
|---|---|---|---|
| Anh. | | | |
| T.P. | | | |
| H. | | | |
| Tr. | | | |
| Dg. | | | |
| Bl. | | | |
| L. | | | |
| K.C. | | | |
| B.K.C. | | | |
| Ce. | | | |
| C. | | | |
| M. | | | |
| M. | | | |
| K. | | | |
| Mz. | | | |
| Mc. | | | |
| V. | | | |
| S. | | | |
| S. | | | |
| A | | | |
| R. | | | |
| P€. | | | |
| G. | | | |
| T.D. | | | |

Loc. in Sec. SW NW SE

Geol.

Contr. Glenn Pool

Pool Blagier

½ Mile

FIRST REPORT

AUG 24 [illegible]

Date Comm.

M I R

Co. Lse. No. Sec. T. R.

FORM 513 REV. SUNRAY

County Graham Elev. 2546

Sec. 21 Twp. 7 Rge. 25W

Company CSO & Colorado O & G

Farm Name Blazier No. 2

| TOPS | DEPTH | LOG | DATUM |
|---|---|---|---|
| Anh. | | | |
| Tp. | 3434 | | 888 |
| H. | 3633 | | 1087 |
| Tr. | | | |
| Dg. Dodge | 3654 | | 1108 |
| Bl. | | | |
| L. | 3671 | | 1125 |
| K.C. | | | |
| B.K.C. | 3881 | | 1335 |
| Ce. | | | |
| C. | | | |
| M. | | | |
| M. | | | |
| K. | | | |
| Mz. | | | |
| Mo. | | | |
| V. | | | |
| S. | | | |
| S. | | | |
| A | | | |
| R. | | | |
| Pe. | | | |
| G. | | | |
| T.D. | 3890 | | |

Loc. in Sec. SW NW SE

Geol.

Contr. Glenn Peel

Pool Blazier

COMPLETE

Date Comm. 8-24-55 OCT 19 1955

8 5/8" @ 238/225 DST 3700-08

open 1 hr. rec. 1140' socsw 1300#

DST 3734-59 open 1 hr. gas to surf.

in 1 hr. rec. 1270' gassy muddy oil

1200# DST 3785-3812 open 1 hr

Rec. 280' oil 540' mco 180' muddy


gassy oil 1210# DST 3819-45

open 1 hr. rec. 340' hmcgo 1265#

OVER

Co. Lse. No. Sec. T. R.

DST 3849-90 open ½ hr. rec. 6' mud
O# 5½" @ 3890 CO to 3875
41/ 3800-10 B/ 120 go 16 hr. 1000A
P/ 393 bo. 24 hr. BHB 884 bo 24 hr.
Comp. P/ 243 bopd -

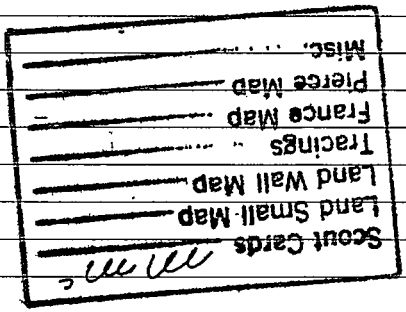


OCT 28 1955