
Graham KANSAS

SECTION 21 TOWNSHIP 7 RANGE 25 W

WELL NO. #5 Blazier

COMPANY C S O & Colorado O & G

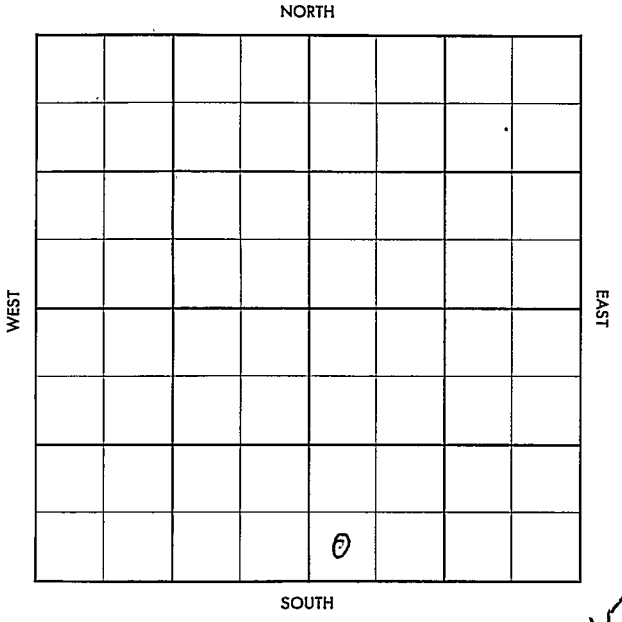

15

Graham KANSAS

SEC.	TWP.	R.
21	7	25W

WELL NO.

#5 Blazier

COMPANY FARM

Cities Service & Colorado O & G

CONTRACTOR

Glenn Peel

Blazier


_____ Ft. from N. Line

_____ Ft. from S. Line

_____ Ft. from E. Line

_____ Ft. from W. Line

SW SW SE

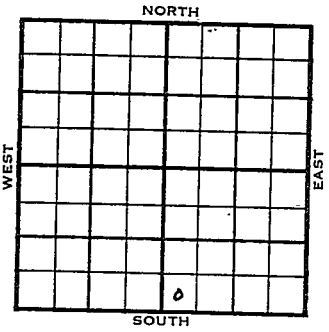

1955	ELEVATION 2539	REPORT
11/16	M I R	
1956		
1-11	Comm. 11-15-55 8 5/8" @ 238/225 5½" @ 3855/175 CO to 3840 33/ 3765-74 FU 1040' oil, 17 hrs. P/ 18.37 boph, 4 hrs. Comp. 251 Bopd H. 3609- Dodge 3634 L. 3650 BKC. 3852 TD 3855'	
		COMPLETED

DX-78

FORM 513 REV. SUNRAY

County Graham Elev.

Sec. 21 Twp. 7 Rge. 25W

Company Cities Service & Colorado O & G

Farm Name Blazier No. 5

TOPS	DEPTH	LOG	DATUM
Anh.			
Tp.			
H.			
Tr.			
Dg.			
Bl.			
L.			
K.C.			
B.K.C.			
Ce.			
C.			
M.			
M.			
K.			
Mz.			
Mg.			
V.			
S.			
S.			
A			
R.			
P€.			
G.			
T.D.			

Loc. in Sec. SWSWSE

Geol.

Contr. Glenn Peel

Pool Blazier

FIRST REPORT

NOV 19 1955

NOV 16 1955

Date Comm.

M I R

Co. Lse. No. Sec. T. R.

FORM 513 REV. SUNRAY

County Graham Elev. 2539

Sec. 21 Twp. 7 Rge. 25W

Company Cities Service & Colo. O & G

Farm Name Blazier No. 5

TOPS	DEPTH	LOG	DATUM
Anh.			
T.P.			
H.	3609		1070
Tr.			
Dg. Dodge	3634		1095
Bl.			
L.	3650		1111
K.C.			
B.K.C.	3852		1313
Ce.			
C.			
M.			
M.			
K.			
Mz.			
Mo.			
V.			
S.			
S.			
A			
R.			
P€.			
G.			
T.D.	3855		

Loc. in Sec. SW SW SE

Geol.

Contr. Glenn Peel

Pool Blazier

COMPLETE

JAN 1 1 1956

Date Comm. 11-15-55

8 5/8" @ 238/225 5½" @ 3855/175

CO to 3840 33/ 3765-74 FU 1040' oil

17 hr. P/ 18.37 boph 4 hr.

Comp. 251 bopd

Co. Lse. No. Sec. T. R.