

State Geological Survey
WICHITA, BRANCH
KANSAS DRILLERS LOG

IMPORTANT
Kans. Geo. Survey request
samples on this well.

API No. 15 — 065 — 20,817
County Number

Operator

Bankoff Oil Company

Address

Drawer 2479 Tulsa, Oklahoma 74101

Well No.

#1

Lease Name

Morphew

Footage Location

510' S of N Line 660 W of E
feet from (N) (S) line feet from (E) (W) line

Principal Contractor

Allen Drilling
3-17-76

Geologist

James W. Thompson

Spud Date

3-13-1976

Total Depth

3612'

P.B.T.D.

Date Completed

3-17-76

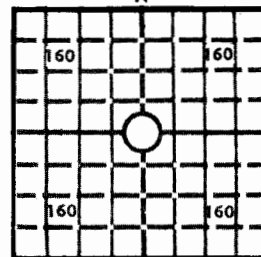
Oil Purchaser

S. 33 T. 7 R. 22 E

Loc. 150' N/C NE SE

County Graham

640 Acres
N



Locate well correctly

Elev.: Gr. 2179

DF 2182 KB 2185

CASING RECORD

Report of all strings set — surface, intermediate, production, etc.

Purpose of string	Size hole drilled	Size casing set (in O.D.)	Weight lbs/ft.	Setting depth	Type cement	Sacks	Type and percent additives
Surface		8 5/8		212'	Cement	1505x	2 1/2 Gel 3 1/2 cc

LINER RECORD

Top, ft.	Bottom, ft.	Sacks cement
----------	-------------	--------------

PERFORATION RECORD

Shots per ft.	Size & type	Depth interval
---------------	-------------	----------------

TUBING RECORD

Size	Setting depth	Packer set at
------	---------------	---------------

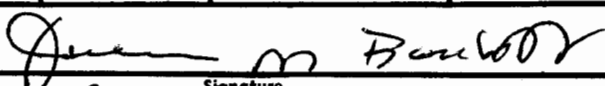
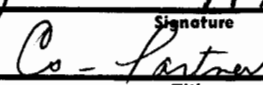
ACID, FRACTURE, SHOT, CEMENT SQUEEZE RECORD

Amount and kind of material used	Depth interval treated
Note	

INITIAL PRODUCTION

Date of first production		Producing method (flowing, pumping, gas lift, etc.)			
Dry Hole					
RATE OF PRODUCTION PER 24 HOURS	Oil	Gas	Water	Gas-oil ratio	
	bbls.	MCF	bbls.	CFPB	
Disposition of gas (vented, used on lease or sold)			Producing interval(s)		

INSTRUCTIONS: As provided in KCC Rule 82-2-125, within 90 days after completion of a well, one completed copy of this Drillers Log shall be transmitted to the State Geological Survey of Kansas, 4150 Monroe Street, Wichita, Kansas 67209. Copies of this form are available from the Conservation Division, State Corporation Commission, 3830 So. Meridian (P.O. Box 17027), Wichita, Kansas 66217. Phone AC 316-522-2206. If confidential custody is desired, please note Rule 82-2-125. Drillers Logs will be on open file in the Oil and Gas Division, State Geological Survey of Kansas, Lawrence, Kansas 66044.

Operator BANKOFF OIL COMPANY		DESIGNATE TYPE OF COMP.: OIL, GAS, DRY HOLE, SWDW, ETC.:	
Well No. 1	Lease Name Morphew		Dry Hole
S 33 T 7 S R 22 E W			
WELL LOG		SHOW GEOLOGICAL MARKERS, LOGS RUN, OR OTHER DESCRIPTIVE INFORMATION.	
Show all important zones of porosity and contents thereof; cored intervals, and all drill-stem tests, including depth interval tested, cushion used, time tool open, flowing and shut-in pressures, and recoveries.			
FORMATION DESCRIPTION, CONTENTS, ETC.	TOP	BOTTOM	NAME
Shale	0	734	SPUD 3-13-76, 8 5/8" @212 w/150, RTD 3612
Sand	734	825	
Shale	825	1320	D & A completed 3-25-76
Sand	1320	1525	
Shale	1525	1804	
Anhydrite	1804	1828	
Shale	1828	2205	
Shale & Lime	2205	3200	
Shale	3200	3230	
Lime	3230	3300	
Shale	3300	3320	
Lime	3320	3340	
Shale	3340	3360	
Lime	3360	3404	
Shale	3404	3407	
Lime	3407	3612	
TD		3612	
USE ADDITIONAL SHEETS, IF NECESSARY, TO COMPLETE WELL RECORD.			
Date Received	 Signature  Title 7/12/76 Date		