


Section 22 Township 7 Range 22W

Well No. #1 Weissbeck

Company Jones, Shelburne & Farmer

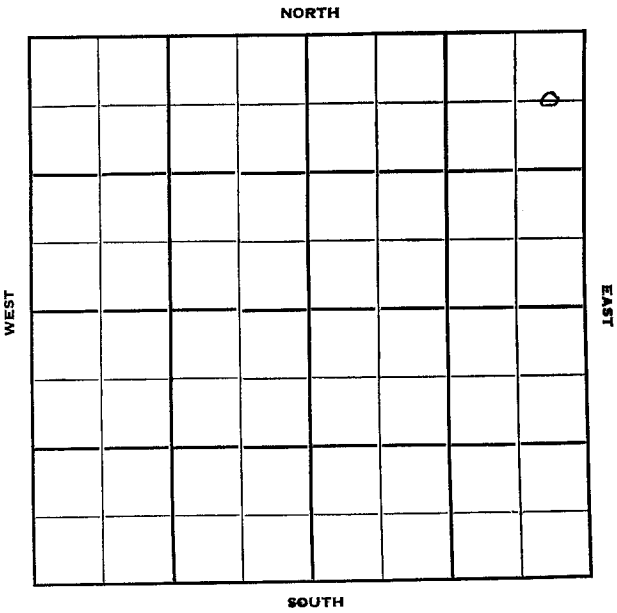

|

Sec. 22 Twp. 7 R. 22 W

Well No. # 1 Weissbeck Farm

Jones, Shelburne & Farmer Company

Contractor

Worcester


660 Ft. from N. Line

Ft. from S. Line

330 Ft. from E. Line

Ft. from W. Line

C E/2 NE NE

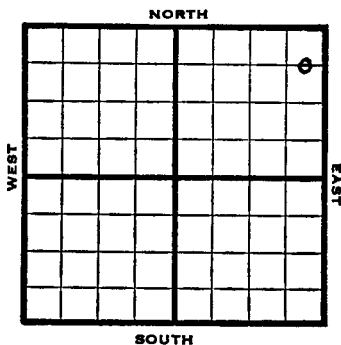

.952	Elev. 2307' REPORT
./30	Location
2/6	C&P
2/13	"
2/20	"
3/5	Heeb 3502'
	Tor 3530'
	Drlg. 3585'
1/12	Lans. 3542' B KC 3737' Marm 3776'
	Arb. 3844'
	DST 3846-48' 1/2 hr, 15' OCM
	RTD 3848' 5" @ 3844'
3/19	<u>Correction:</u> Arb. 3848 TD 3852
	5" @ 3848
	New Dope:
	DP 3852 1000 A S/1 Boph sq shoe
	12/3848-52 1000 A
3/25	S/ 16 BOPH decreased to 2 BOPH POP
4/1	POP
4/9	"
4/23	P/57 BO 24 hrs.
4/30	NR
5/7	"
5/14	"
5/20	"
5/28	"
6/11	"

OVER

1952  
6/18 NR  
6/25 NR  
7/2 "  
7/9 "  
7/17 "  
7/23 "

7/30 Spud 2-20-52  
D & A TD 3852' 8" @ 160  
Anhy 1912' Heeb 3502' Tor. 3530'  
Lans. 3542' B KC 3737' Marm. 3776  
DST 3846-48 open  $\frac{1}{2}$  hr. rec 15' OCM  
Arb. 3848' 5" @ 3848' TD 3852'  
1000 A S/1 BOPH 12/3848-52 1000 A  
S/16 BOPH dec. to 2 BOPH P/57 BO  
24 hr. oil decreased. D & A

**ABANDONED**

County **Graham** State **Kansas**

Sec. **22** (Blk.) **7** (Sur.) **22N** Map No.

Operator **Jones, Shelburne & Farmer**

Well No. **1** Farm **Weissbeck**

Elev. Location **C E/2 NE NE**


**FIRST REPORT**

**660** Ft. From **N** Line **NE**

**330** Ft. From **E** Line **Quart**

Ist. Report **JAN 30 1952**

Completion

Remarks

Spudding Date

Drlg. Data **Worchester**

**Location**

**J. G. MCGEHEE**

