FORM 51 25M 3-49 PETROL


KANSAS

Rooks

Section 22 Township 7 Range 19-W

Well No. #1 Grover

Company Anschutz Drlg.

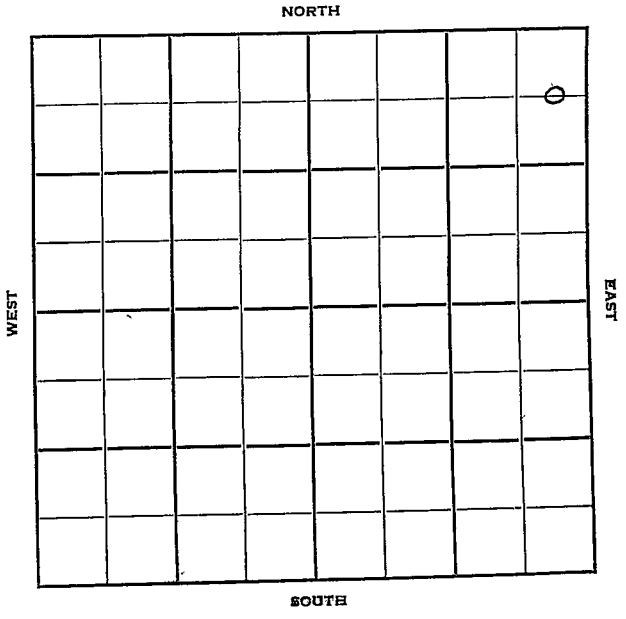

FORM 252-B
10M 9-49 PETROL

Rooks KANSAS

Sec. 22 Twp. 7 R. 19W

Well No. #1 Grover Farm

Anschutz Drlg Company

Anschutz Drlg. Contractor


660' Ft. from N. Line

Ft. from S. Line

330' Ft. from E. Line

Ft. from W. Line

C E L NE NE

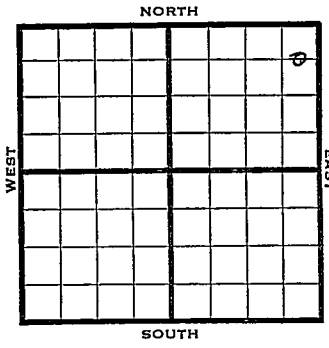

1950	Elev 1935 REPORT
6/28	Spud 6-21-50 8" @ 160' Anhy 1430-65 Drlg. 2709'
8/23	8" @ 160 Anny 1430 Top 2880 Lans 3126 DST 3177-32-5 opn 20 min rec 15' mud SSO DST 3275-90 opn 1 hr rec 70' o & gcm Arb 3396-3425 5" @ 3411 2½ go 2½ gwph DD 3427 37 gw 10 go 1 hr SP 3321, 19/3296-3303, 15/3297-3302 B/1 qt oil 1 hr 500 A S/3 bo 1 hr S/2 bo 1 hr 3000 A S/43 bo 7 hr SP 3282½ 23/3272-80, S/27 bo 7 hr 500 A S/20 bo 6 hr S/19 bo 6 hr 8000 A S/8½ bo S/4½ bo P/95 bo 19 hr Comp 143 bopd 4% wtr Completed COMPLETED

3396
1935
1461

Form 26 200 Bks. 11-49 Petrol

Kansas

Map No. _____ Sec. 22 Twp. 7 R. 19W

Well No. 1 Grover

Anschutz Drlg. Company

Anschutz Drlg. Contractor

C EL NE NE


660 Ft. from N. Line

_____ Ft. from S. Line

330 Ft. from E. Line

_____ Ft. from W. Line

SECTION PLAT

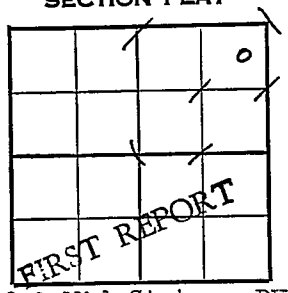

Rooks County Gulf & Mid-States DHM

Location _____

Rig up _____

Drilling and Remarks:

Spud 6-21-50

8" (160

Anhy 1430-65

drlg. 2709

RECORD

Cased _____ in., _____ ft.

Sand _____

Gas _____

Oil _____

Total Depth _____

PRODUCTION

1st 24 hrs. Nat. _____

1st 24 hrs. after shot _____

Gas _____ Cu. Ft.

Dry Hole _____

Abandoned _____

Date

JUN 28 1950 19

J. E. TYRA Scout

FORM 275 FOR SALE BY KANSAS BLUE PRINT CO.


County Rooks State Kansas

Sec. 22 (Blk. Twp.) 7 (Sur. Rge.) 19W Map No.

Operator Anschutz Drlg.

Well No. 1 Farm Grover

Elev. 1935 Location C E L NE NE

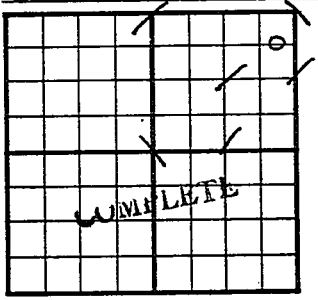

660 Ft. From N Line NE

330 Ft. From E Line Quarter

1st. Report

Completion AUG 23 1950

Remarks

Spudding Date

Drlg. Data Oil well TD 3427

8" @ 160 Anhy 1430-65 Top. 2880

Lans. 3126 DST 3177-3205 open 20 min.

Rec. 15' mud SSO DST 3275-90 open 1 hr.

Rec. 70' o & gcm Arb. 3396-3425 5" @ 3411

2½ go 2½ gwph DD 3427 37 gw 10 go 1 hr.

SP 3321 19/ 3296-3303 15/ 3297-3302

B/ 1 qt. oil 1 hr. 500 A S/ 3 bo 1 hr.

S/ 2 bo 1 hr. 3000 A S/ 43 bo 7 hr.

SP 3282½ 23/ 3272-80 S/ 27 bo 7 hr.

500 A S/ 20 bo 6 hr. S/ 19 bo 6 hr.

8000 A S/ 8½ bo S/ 4¼ bo P/ 95 bo 19 hr.

Comp. 143 bopd 4% water

J. E. TYRA