
FORM 51 25M 8-50 WESTERN Rooks KANSAS

Section 22 Township 7 Range 19W

Well No. #1 Roy

Company Greekmore Drlg.

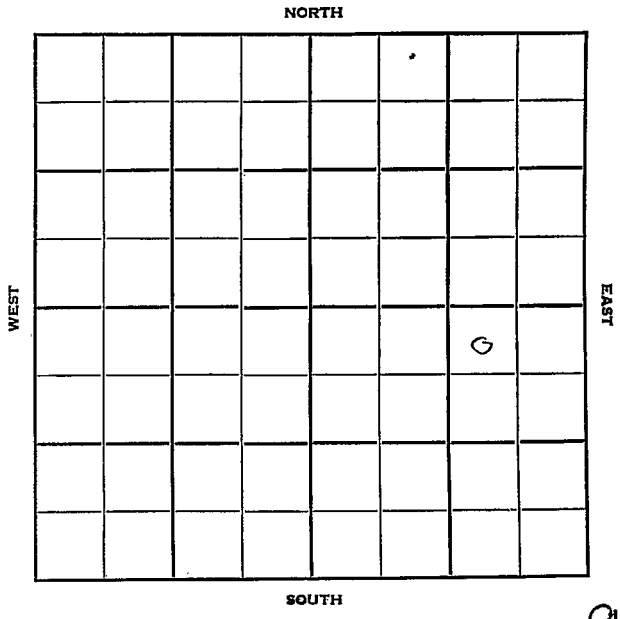

9

FORM 252-B
10M 10-50 PETROL

KANSAS

Sec. 22 Twp. 7 R. 19W

Well No. #1 Roy Farm

Creekmore Drlg. Company

Contractor

Grover


330 Ft. from N. Line

Ft. from S. Line

990 Ft. from E. Line

Ft. from W. Line

NW NE SE

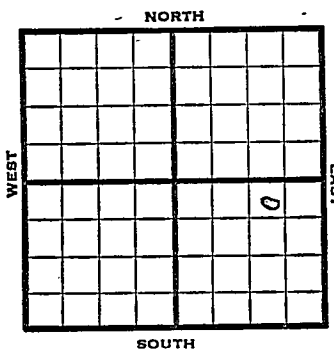

REPORT

1952 Elev. 1893'

1/23 RUR

2/5 DST 3010-28, 1 hr. 2250' SW
Heeb. 3045 Tor. 3068
Lans. 3083
DST 3110-49, ½ hr. 10' R mud
DST 3228-65, 1 hr. 150' HOCM 50% oil
1030# BHP
Arb. 3383
DST 3387-3427, ½ hr. 2320' SW
1092# BHP RTD 3427

2/13 13/3259-62, Test 1 gal oil & 1 gal wtr pkr 500 A
S/3 BOPH No wtr 2500 A
S/5½ BOPH for 12 hr.

2/20 5" @ 3295 S/78 BO in 12 hrs. POP

3/5 POP

3/12 POP

3/19 "

3/25 "

4/1 NR

4/9 Spud 1-23-52
Oil Well TD 3427
8" @ 110 DST 3010-28 open 1 hr.
rec. 2250' sw
Heeb. 3045 Tor. 3068 Lans. 3083

OVER

1952

4/9 DST 3110-49 open ½ hr. rec. 10' drlg. mud
DST 3228-65 open 1 hr. rec. 150' homm 50% oil Arb. 3383
DST 3387-3427 open ½ hr. rec. 2320' sw TD 3427 13/ 3259-62 1 go 1 gwph 500 A S/ 3 boph ho wtr. 2500 A S/ 3½ boph 12 hr. 5" @ 3295
S/ 78 bo 12 hr.
Comp. 50 bopd

COMPLETED

FORM 275 FOR SALE BY KANSAS BLUE PRINT CO.


County Rooks State Kansas

Sec. 22 (Blk. Twp.) 7 (Sur. Rge.) 19W Map No.

Operator Creekmore Drlg.

Well No. 1 Farm Roy

Elev. Location NW NE SE

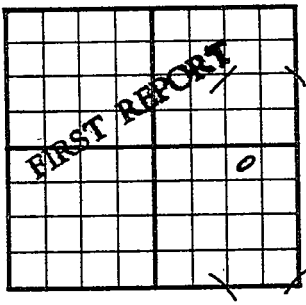

330 Ft. From N Line SE

990 Ft. From E Line Quarter

1st. Report JAN 23 1952

Completion

Remarks

Spudding Date

Drlg. Data Grover

RUR

J. E. TYRA

FORM 275 FOR SALE BY KANSAS BLUE PRINT CO.


County Rooks State Kansas

Sec. 22 (Blk. Twp.) 7 (Sur. Rge.) 19W Map No.

Operator Creekmore Drlg.

Well No. 1 Farm Roy

Elev. 1893 Location NW NE SE

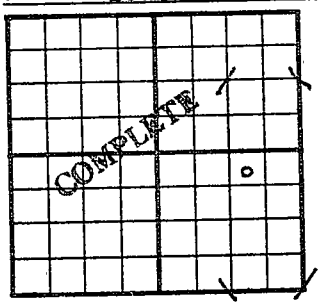

330 Ft. From Line SE

990 Ft. From Line Quarter

Ist. Report

Completion APR 9 1952

Remarks Grover Pool

Spudding Date 1-23-52

Drlg. Data Oil well TD 3427

8" @ 110 DST 3010-28 open 1 hr.

Rec. 2250' sw Heeb. 3045 Tor. 3068

Lans. 3083 DST 3110-49 open ½ hr.

Rec. 10' drlg. mud DST 3228-65

open 1 hr. Rec. 150' hocm 50% oil

Arb. 3383 DST 3387-3427 open ½ hr.

Rec/ 2320' sw TD 3427 13/ 3259-62

1 go 1 gwph 500 A S/ 3 boph no water

2500 A S/ 3½ boph 12 hr. 5" @ 3295

S/ 78 bo 12 hr. Comp. 50 bopd

J. G. McGEHEE