

COPY

SIDE ONE

STATE CORPORATION COMMISSION OF KANSAS
OIL & GAS CONSERVATION DIVISION
WELL COMPLETION FORM
ACO-1 WELL HISTORY
DESCRIPTION OF WELL AND LEASE

Operator: License # 5011

Name: Viking Resources, Inc.

Address 105 S. Broadway, Suite 1040

City/State/Zip Wichita, KS 67202-4224

Purchaser: _____

Operator Contact Person: James B. Devlin

Phone (316) 262-2502

Contractor: Name: Abercrombie Drilling, Inc.

License: 5422

Wellsite Geologist: Robert C. Patton

Designate Type of Completion
 New Well Re-Entry Workover

Oil SWD Temp. Abd.
 Gas Inj Delayed Comp
 Dry Other (Core, Water Supply, etc.)

If OWMO: old well info as follows:
Operator: N/A

Well Name: _____

Comp. Date _____ Old Total Depth _____

Drilling Method:
 Mud Rotary Air Rotary Cable

1-12-91 1-17-91
Spud Date Date Reached TD Completion Date

API NO. 15- 065-22,619

County Graham

NE NE NE Sec. 9 Twp. 7S Rge. 23 East West

4950' Ft. North from Southeast Corner of Section

330' Ft. West from Southeast Corner of Section
(NOTE: Locate well in section plat below.)


Lease Name Seeger Well # 1

Field Name Wildcat

Producing Formation BKC

Elevation: Ground 2405 KB 2410

Total Depth 3900' PBTD _____

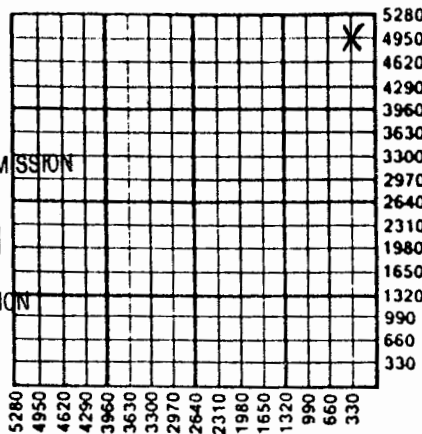

AI-2 D & O

Amount of Surface Pipe Set and Cemented at 207' Feet

Multiple Stage Cementing Collar Used? Yes No

If yes, show depth set _____ Feet

If Alternate II completion, cement circulated from _____

feet depth to _____ w/ _____ sx cmt.

RECEIVED
STATE CORPORATION COMMISSION

MAY 13 1991

CONSERVATION DIVISION
Wichita, Kansas

INSTRUCTIONS: This form shall be completed in triplicate and filed with the Kansas Corporation Commission, 200 Colorado Derby Building, Wichita, Kansas 67202, within 120 days of the spud date of any well. Rule 82-3-130, 82-3-107 and 82-3-106 apply. Information on side two of this form will be held confidential for a period of 12 months if requested in writing and submitted with the form. See rule 82-3-107 for confidentiality in excess of 12 months. One copy of all wireline logs and drillers time log shall be attached with this form. ALL CEMENTING TICKETS MUST BE ATTACHED. Submit CP-4 form with all plugged wells. Submit CP-111 form with all temporarily abandoned wells. Any recompletion, workover or conversion of a well requires filing of ACO-2 within 120 days from commencement date of such work.

All requirements of the statutes, rules and regulations promulgated to regulate the oil and gas industry have been fully complied with and the statements herein are complete and correct to the best of my knowledge.

Signature James B. Devlin

Title President Date 5-10-91

Subscribed and sworn to before me this 10th day of May, 1991.

Notary Public Paula R. Dunagan

Notary Public **PAULA R. DUNAGAN**
STATE OF KANSAS
My Appt. Exp. Feb 2, 1993

K.C.C. OFFICE USE ONLY
F Letter of Confidentiality Attached
C Wireline Log Received
C Drillers Timelog Received

Distribution
 KCC SWD/Rep NGPA
 KGS Plug Other (Specify) IS

