

State Geological Survey

WICHITA BRANCH KANSAS DRILLERS LOG

15-065-20964

API No. 15 — 005 — 20964
County Number

Operator

John O. Farmer, Inc.

Address

Box 352, Russell, Kansas 67665

Well No.

1

Lease Name

REESE

Footage Location

660

feet from (N) XX line

660

feet from (E) X (W) line

Principal Contractor

John O. Farmer, Inc.

Geologist

Sam Farmer

Spud Date

11-3-77

Total Depth

3905

P.B.T.D.

Date Completed

11-10-77

Oil Purchaser


None -- D & A

S. 15 T. 7S R. 23W^E_W

Loc. C NW SE

County Graham

640 Acres
N

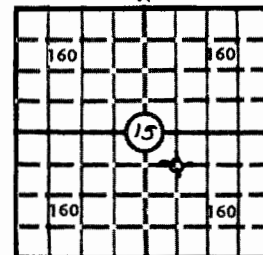

Locate well correctly

Elev.: Gr. 2400

DF 2403 KB 2405

CASING RECORD

Report of all strings set — surface, intermediate, production, etc.

Purpose of string	Size hole drilled	Size casing set (in O.D.)	Weight lbs/ft.	Setting depth	Type cement	Sacks	Type and percent additives
Surface	12 $\frac{1}{4}$	8-5/8	26	207	Common	170	

LINER RECORD

Top, ft. Bottom, ft. Sacks cement

PERFORATION RECORD

Shots per ft. Size & type Depth interval

TUBING RECORD

Size Setting depth Packer set at

ACID, FRACTURE, SHOT, CEMENT SQUEEZE RECORD

Amount and kind of material used

Depth interval treated

INITIAL PRODUCTION

Date of first production

Producing method (flowing, pumping, gas lift, etc.)

RATE OF PRODUCTION
PER 24 HOURS

Oil

bbls.

Gas

MCF

Water

Gas-oil ratio


bbls.

CFPB

Disposition of gas (vented, used on lease or sold)

Producing interval (s)

INSTRUCTIONS: As provided in KCC Rule 82-2-125, within 90 days after completion of a well, one completed copy of this Drillers Log shall be transmitted to the State Geological Survey of Kansas, 4150 Monroe Street, Wichita, Kansas 67209. Copies of this form are available from the Conservation Division, State Corporation Commission, 3830 So. Meridian (P.O. Box 17027), Wichita, Kansas 66217. Phone AC 316-522-2206. If confidential custody is desired, please note Rule 82-2-125. Drillers Logs will be on open file in the Oil and Gas Division, State Geological Survey of Kansas, Lawrence, Kansas 66044.

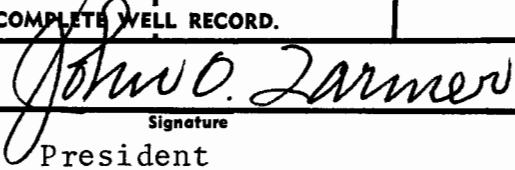Operator John O. Farmer, Inc.		DESIGNATE TYPE OF COMP.: OIL, GAS, DRY HOLE, SWDW, ETC.:	
Well No. 1	Lease Name REESE		Dry Hole
S <u>15</u> T <u>7</u> S <u>R</u> <u>23</u> ^{NE} _W			
WELL LOG		SHOW GEOLOGICAL MARKERS, LOGS RUN, OR OTHER DESCRIPTIVE INFORMATION.	
Show all important zones of porosity and contents thereof; cored intervals, and all drill-stem tests, including depth interval tested, cushion used, time tool open, flowing and shut-in pressures, and recoveries.			
FORMATION DESCRIPTION, CONTENTS, ETC.	TOP	BOTTOM	NAME
			DEPTH
Shale & Sand	0	1645	Sample Tops:
Sand	1645	1855	Anhydrite 2094 (+ 311)
Red Bed	1855	2094	Heebner 3663 (-1258)
Anhydrite	2094	2128	Toronto 3690 (-1285)
Shale & Shells	2128	2595	Lansing 3708 (-1303)
Shale & Lime	2595	3195	B/KC 3898 (-1493)
Lime & Shale	3195	3325	T.D. 3905 (-1500)
Shale & Lime	3325	3645	
Lime	3645	3905	
USE ADDITIONAL SHEETS, IF NECESSARY, TO COMPLETE WELL RECORD.			
Date Received	 Signature President Title November 11, 1977 Date		