
FORM 51 25M 8-50 WESTERN

Rooks KANSAS

Section 23 Township 7 Range 18W

Well No. #1 Tatman

Company Harry Koplin

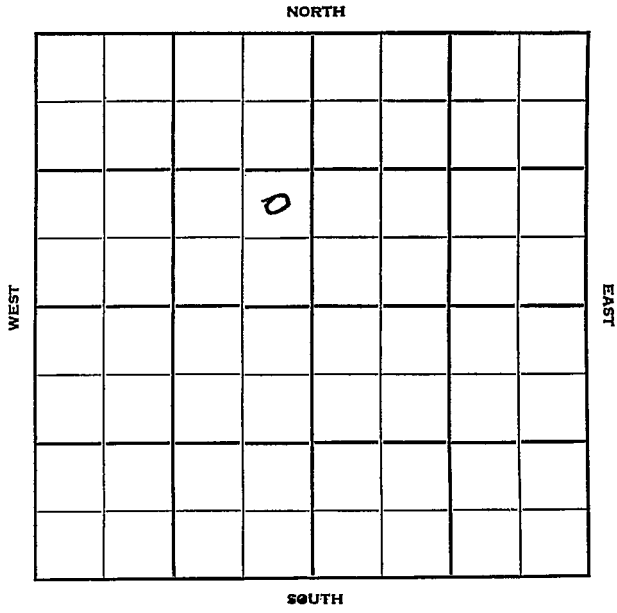

6

FORM 252-B
10M 8-51 TPCO.

Rooks KANSAS ✓

Sec. 23 Twp. 7 R. 18 W

Well No. # 1 Tatman Farm

Harry Koplin Company

Contractor

Wildcat

Ft. from N. Line


990 Ft. from S. Line

330 Ft. from E. Line

Ft. from W. Line

NE SE NW

Texas DHM

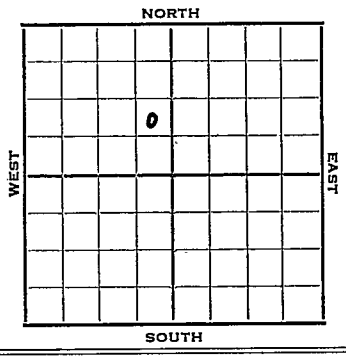

REPORT

1952 Elev. 1770'

7/9 Spud 7-2-52
8" @ 1058
Drlg. 2340'

7/16 Spud 7-2-52
D & A TD 3335' 8" @ 1058
Heeb 2935' Tor. 2959' Lans. 2977
DST 3160-85 open ½ hr. rec 30' mud
B KC 3200' Marm. 3219' Cong. 3291
Arb. 3306'
TD 3335' D & A

ABANDONED

FORM 275 FOR SALE BY KANSAS BLUE PRINT CO.


County Rooks State Kansas

Sec. 23 (Blk. / Twp.) 7 (Sur. / Rge.) 18W Map No.

Operator Harry Koplin

Well No. 1 Farm Tatman

Elev. 1770 Location NE SE NW

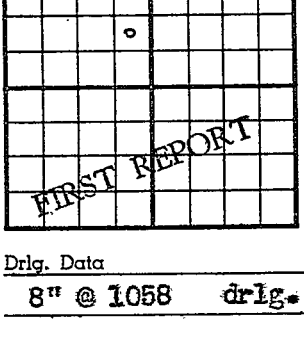

990 Ft. From S Line NW

330 Ft. From E Line Quarter

1st. Report JUL 9 1952

Completion

Remarks Texas DHM

Spudding Date 7-2-52

Drlg. Data Wildcat

8" @ 1058 drlg. 2340

J. G. McGEHEE

FORM 275 FOR SALE BY KANSAS BLUE PRINT CO.


County Rooks State Kansas

Sec. 23 (Blk. Twp.) 7 (Sur. Rge.) 18W Map No.

Operator Harry Koplin

Well No. 1 Farm Tatman

Elev. 1770 Location NE SE NW

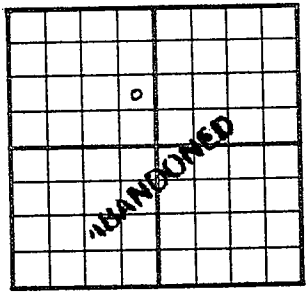

990 Ft. From S Line NW

330 Ft. From E Line Quarter

1st. Report

Completion JUL 16 1952

Remarks Wildcat

Spudding Date 7-2-52

Drlg. Data D & A TD 3335

8" @ 1058 Heeb. 2935 Tor. 2959

Lans. 2977 DST 3160-85 open ½ hr.

Rec. 30' mud B KC 3200 Marm. 3219

Cong. 3291 Arb. 3306 TD 3335

D & A

J. G. McGEHEE