

Wildcat

FORM 51 10M 2-49 PETROL

KANSAS

Rooks Co.

Section 23 Township 7 Range 19WWell No. #1 WalkerCompany Mid-States

Harber Drlg NORTH Cont.

							0

WEST

EAST

SOUTH

9

KANSAS Rocks

Sec. 23 Twp. 7 R. 19W ✓

Well No. #1 Walker Farm

Mid-States Company

Wildcat


330' Ft. from N. Line

_____ Ft. from S. Line

330' Ft. from E. Line

_____ Ft. from W. Line

NE SE

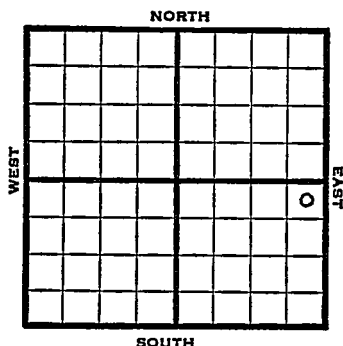

1949

Elev 1916' REPORT

8/17

RUR

8/24

8" @ 225'

Drlg. 2185

8/31

TD 3460'

Lans 3083'

Gong 3384'

Arb. 3406'

Aband.

ABANDONED

Map No. _____ Sec. 23 Twp. 7 R. 19W

Well No. 1 Walker

Mid-States Company

Harbar Drlg. Contractor

NE SE


**FIRST REPORT
SECTION PLAT**

330 Ft. from N. Line

_____ Ft. from S. Line

330 Ft. from E. Line

_____ Ft. from W. Line

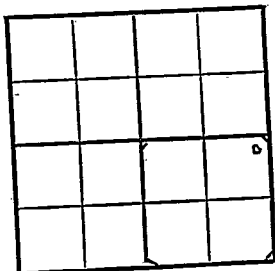

Rooks County

Location _____

Rig up _____

Drilling and Remarks:

R U R

RECORD

Cased _____ in., _____ ft.

Sand _____

Gas _____

Oil _____

Total Depth _____

PRODUCTION

1st 24 hrs. Nat. _____

1st 24 hrs. after shot _____

Gas _____ Cu. Ft.

Dry Hole _____

Abandoned _____

Date

AUG 17 1949 19

S. J. LEWIS Scout

Kansas

Map No. K 65 Sec. 23 Twp. 7 R. 19WWell No. 1 Walker


Mid-States

Company

ABANDONED

Contractor

NE SE

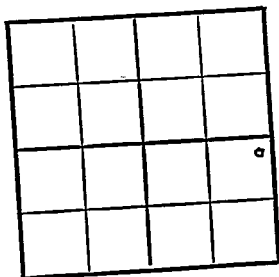E. 1916
SECTION PLAT330 Ft. from N. Line Ft. from S. Line330 Ft. from E. Line Ft. from W. Line

Rooks County

Location Rig up

Drilling and Remarks:

Lam 8083Comp 3384Per 83426

RECORD

Cased in., ft.Sand Gas Oil Total Depth 3460

PRODUCTION

1st 24 hrs. Nat. 1st 24 hrs. after shot Gas Cu. Ft.Dry Hole Abandoned

Date

AUG 31 1949 19

S. J. LEWIS

Scout