

36-7-24W

STATE CORPORATION COMMISSION OF KANSAS
OIL & GAS CONSERVATION DIVISION
WELL COMPLETION OR RECOMPLETION FORM
ACO-1 WELL HISTORY
DESCRIPTION OF WELL AND LEASE

API NO. 15-...065-22,039...
County...Graham...
...NE NW SE Sec.36.. Twp.7...Rge.24... East West

Operator: License # ...D & D Productions...
Name9514.....
Address 403 S Main St.....
City/State/Zip Pratt, KS. 67124.....

.....2440' Ft North from Southeast Corner of Section
.....1520' Ft West from Southeast Corner of Section
(Note: Locate well in section plat below)

Purchaser.....N/A.....

Lease Name...Ray.....Well # A-1...

Operator Contact Person Darrel Anderson....
Phone ...(316)672-2601.....

Field Name....Wildcat.....

Contractor: License # ...5149.....
NameWheatstate Oil, Inc.....


Producing Formation.....N/A.....

Wellsite Geologist Bruce Ard.....
Phone...(316)775-6106.....

Elevation: Ground.....2356'.....KB...2361'.....

Designate Type of Completion
 New Well Re-Entry Workover
 Oil SWD Temp Abd
 Gas Inj Delayed Comp.
 Dry Other (Core, Water Supply etc.)

Section Plat

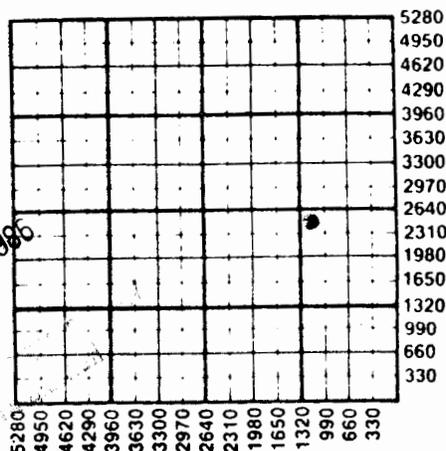

If OWWO: old well info as follows:
Operator
Well Name
Comp. DateOld Total Depth.....

WATER SUPPLY INFORMATION

Disposition of Produced Water: Disposal
Docket # Repressuring

WELL HISTORY

Drilling Method:
 Mud Rotary Air Rotary Cable

Questions on this portion of the ACO-1 call:
Water Resources Board (913) 296-3717

..8-9-86.. ..8-15-86.. ..8-15-84..
Spud Date Date Reached TD Completion Date

Source of Water: Hauled
Division of Water Resources Permit #.....

..3881'.....
Total Depth PBTD

Groundwater.....Ft North from Southeast Corner
(Well)Ft West from Southeast Corner of
Sec Twp Rge East West

Amount of Surface Pipe Set and Cemented at 200 feet
Multiple Stage Cementing Collar Used? Yes No
If yes, show depth set.....feet
If alternate 2 completion, cement circulated
from.....feet depth to.....w/.....SX cmt
Cement Company Name ...Allied.....
Invoice #39658.....

Surface Water.....Ft North from Southeast Corner
(Stream, pond etc).....Ft West from Southeast Corner
Sec Twp Rge East West

Other (explain) Hauled.....
(purchased from city, R.W.D. #)

INSTRUCTIONS: This form shall be completed in duplicate and filed with the Kansas Corporation Commission, 200 Colorado Derby Building, Wichita, Kansas 67202, within 90 days after completion or recompletion of any well. Rule 82-3-130 and 82-3-107 apply.
Information on side two of this form will be held confidential for a period of 12 months if requested in writing and submitted with the form. See rule 82-3-107 for confidentiality in excess of 12 months.
One copy of all wireline logs and drillers time log shall be attached with this form. Submit CP-4 form with all plugged wells. Submit CP-111 form with all temporarily abandoned wells.

SIDE TWO

Operator Name D & D Productions Lease Name..... RAY Well #A-1...

Sec..... 36. Twp. 7S Rge. 24 East West County..... Grabam

WELL LOG

INSTRUCTIONS: Show important tops and base of formations penetrated. Detail all cores. Report all drill stem tests giving interval tested, time tool open and closed, flowing and shut-in pressures, whether shut-in pressure reached static level, hydrostatic pressures, bottom hole temperature, fluid recovery, and flow rates if gas to surface during test. Attach extra sheet if more space is needed. Attach copy of log.

Drill Stem Tests Taken Yes No
 Samples Sent to Geological Survey Yes No
 Cores Taken Yes No

Formation Description
 Log Sample

Name	Top	Bottom
Heebner	3595'	
Toronto	3621'	
Lansing	3641'	
Base K.C.	3844'	
RTD/LTD	3881'	

MAY 06 1986


Dry and abandoned

CASING RECORD <input type="checkbox"/> New <input type="checkbox"/> Used							
Report all strings set-conductor, surface, intermediate, production, etc.							
Purpose of String	Size Hole Drilled	Size Casing Set (In O.D.)	Weight Lbs/Ft.	Setting Depth	Type of Cement	#Sacks Used	Type and Percent Additives
N/A							
PERFORATION RECORD				Acid, Fracture, Shot, Cement Squeeze Record			
Shots Per Foot	Specify Footage of Each Interval Perforated			(Amount and Kind of Material Used)		Depth	
TUBING RECORD				Liner Run <input type="checkbox"/> Yes <input type="checkbox"/> No			
Size	Set At	Packer at					
Date of First Production		Producing Method					
		<input type="checkbox"/> Flowing <input type="checkbox"/> Pumping <input type="checkbox"/> Gas Lift <input type="checkbox"/> Other (explain).....					
		Oil	Gas	Water	Gas-Oil Ratio	Gravity	