
DX 78-1

Sheridan KANSAS

Section 24 Township 7 Range 26W

Well No. 1 Barnett

Company Jones, Shelburne & Farmer

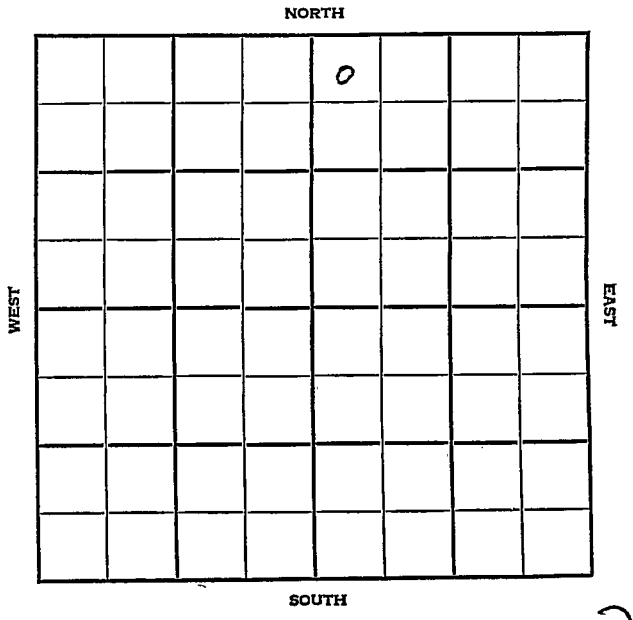

2

Sheridan KANSAS

SEC.	TWP.	R.
24	7	26W

WELL NO. 1 Barnett

COMPANY FARM

Jones, Shelburne & Farmer

CONTRACTOR


Wildcat

330 Ft. from N. Line

Ft. from S. Line

Ft. from E. Line

330 Ft. from W. Line

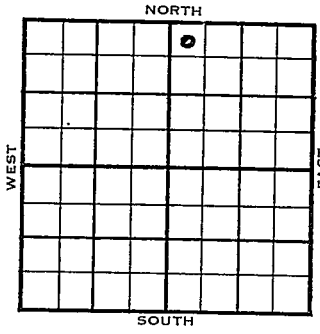

NW NW NE
Skelly DHM

1955	ELEVATION 2570'	REPORT
1/12	Spud 1-11-54	
1/26	Spud 1-11-55 D&A TD 4380' 8" @ 240' Anhy 2260', Heeb. 3768', Tor. 3790', Lans. 3806', B KC 4012', Miss chert 4314', Miss Lime 4350' TD 4380' D&A ABANDONED	

DX-78

FORM 275 FOR SALE BY KANSAS BLUE PRINT CO.


County Sheridan State Kansas

Sec. 24 (Blk. Twp.) 7 (Sur. Rge.) 26W Map No.

Operator Jones, Shelburne & Farmer

Well No. 1 Farm Barnett

Elev. Location NW NW NE

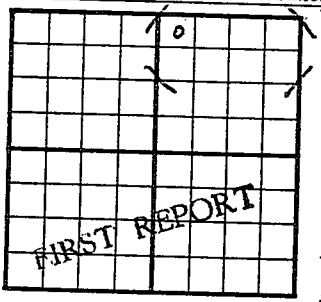

330 Ft. From N Line NE

330 Ft. From W Line Quarter

1st. Report JAN 1 2 1955

Completion

Remarks Skelly - DHM

Spudding Date 1-11-55

Drlg. Data Wildcat

FABEN GILSTRAP

FORM 275 FOR SALE BY KANSAS BLUE PRINT CO.


County Sheridan State Kansas

Sec. 24 (Blk. Twp.) 7 (Sur. Rge.) 26W Map No.

Operator Jones, Shelburne & Farmer

Well No. 1 Farm Barnett

Elev. 2570 Location NW NW NE

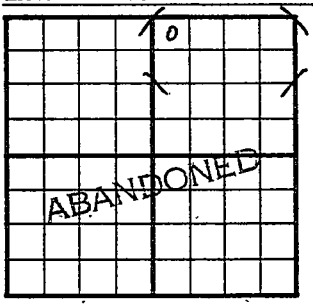

330 Ft. From N Line NE

330 Ft. From W Line Quarter

1st. Report

Completion JAN 26 1955

Remarks Wildcat

Spudding Date 1-11-55

Drlg. Data D & A TD 4380

8" @ 240 Anhy 2260 Heeb. 3768

Tor. 3790 Lans. 3806 B KC 4012

Miss. chert 4314 Miss. lime 4350

TD 4380

D & A

FABEN GILSTRAP