FORM 51 10M 8-47 KANSAS


Graham

Section 24 Township 7 Range 21W

Well No. 1 Alexander

Company Harry Gore

Wildcat

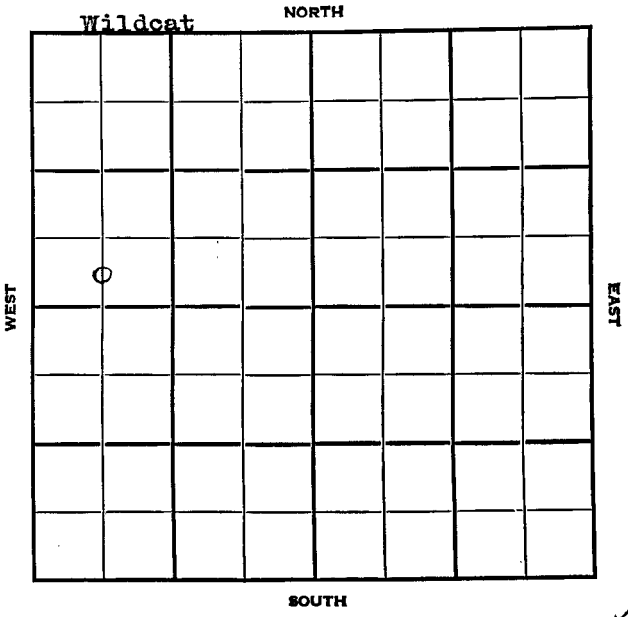

5

FORM 252-A
5M 9-47 PETROL

KANSAS Graham ✓

Sec. 24 Twp. 7 R. 21W

Well No. #1 Alexander Farm

~~Harry Gore~~ Company
Wildcat


330 Ft. from N. Line

Ft. from S. Line

Ft. from E. Line

660 Ft. from W. Line

C S L SW NW

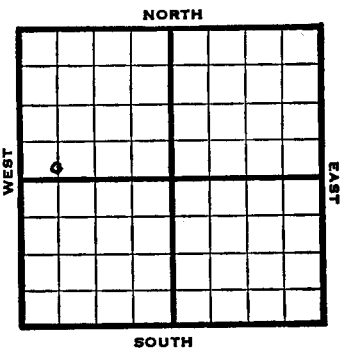

1947	Elevation 2093 REPORT
10/8	Location
10/15	Surface hole.
10/22	8" @ 221' Anhydrite 1687' Drlg. 2835'
10/29	Lansing 3337' Arbuckle 3625' TD 3658'
	ABANDONED

Form 26 200 Bks. 10-46 Petrol

Wildcat

Kansas

Map No. _____ Sec. 24 Twp. 7 R. 21W


Well No. 1 Alexander

Harry Gore Company

FIRST REPORT Contractor

C S L SW NW

SECTION PLAT

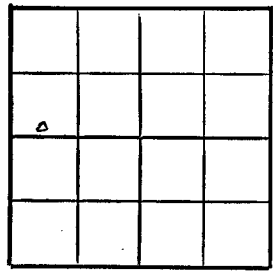

_____ Ft. from N. Line

330 Ft. from S. Line

_____ Ft. from E. Line

660 Ft. from W. Line

GRAHAM

Location _____

Rig up _____

Drilling and Remarks:

RECORD

Cased _____ in., _____ ft.

Sand _____

Gas _____

Oil _____

Total Depth _____

PRODUCTION

1st 24 hrs. Nat. _____

1st 24 hrs. after shot _____

Gas _____ Cu. Ft.

Dry Hole _____

Abandoned _____

Date

OCT 8 1947

19 S. J. LEWIS Scout

Form 26 200 Bks. 10-46 Petrol

Kansas

Wildcat

Map No. 65 Sec. 24 Twp. 7 R. 21W

Well No. 1 Alexander


Harry Gore Company

ABANDONED Contractor

E 12083

C S L SW NW

SECTION PLAT

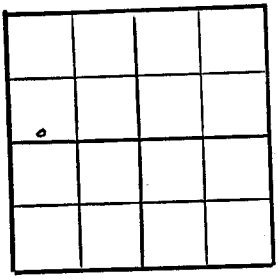

____ Ft. from N. Line

330 Ft. from S. Line

____ Ft. from E. Line

660 Ft. from W. Line

Graham County

Location

Rig up

Drilling and Remarks:

Lans 3337

AR 3625

RECORD

Cased ____ in., ____ ft.

Sand

Gas

Oil

Total Depth 3658

PRODUCTION

1st 24 hrs. Nat.

1st 24 hrs. after shot

Gas Cu. Ft.

Dry Hole

Abandoned

Date

OCT 29 1947 19____ S. J. LEWIS Scout