

Graham

KANSAS

24

7S

23W

SECTION _____ TOWNSHIP _____ RANGE _____


WELL NO. ~~#1 Mitchell~~ #1 Fabricius "B"

COMPANY Imperial

NORTH C SW SE

WEST

EAST

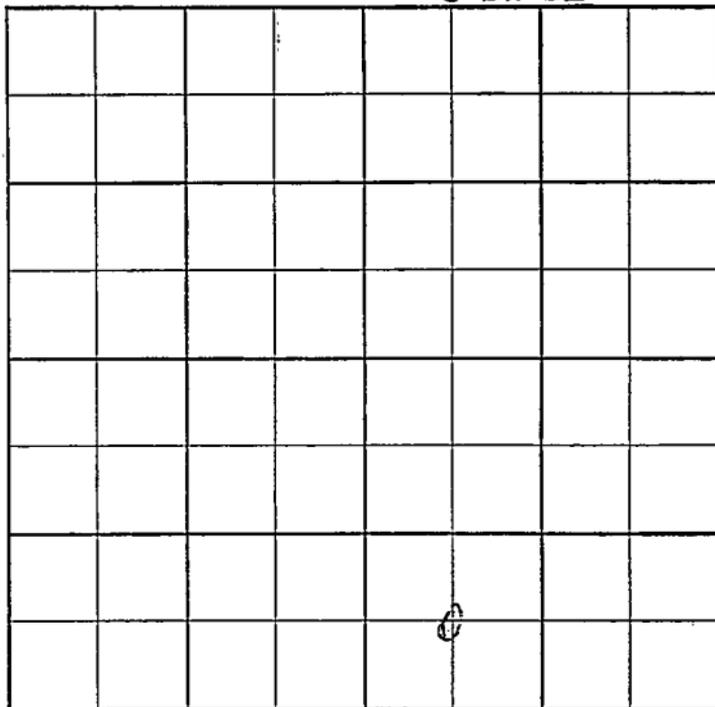

SOUTH

15

~~Twp~~ ~~Pool~~
~~Co~~ ~~Fabricuis~~

S-513-B

County Graham Elev. _____
 Sec. 24 Twp. 7 Rge. 23W
 Company Imperial
 Farm Name Mitchell No. 1

TOPS	DEPTH	LOG	DATUM
Anh.			
Tp.			
H.			
Tr.			
Dg.			
B.L.			
L.			
K.C.			
B.K.C.			
Ce.			
C.			
M.			
M.			
K.			
Mz.			
Mq.			
V.			
S.			
S.			
A.			
R.			
Pf.			
G.			
T.D.			

Loc. in Sec. C SW SE

Geol. _____
 Contr. _____

Pool Fabricuis

JUL 15 1958
FIRST REPORT

Date Comm. 7-14-58
8" @ 227 w/175, Drlg. 1220

Co.

Use

No.

Sec.

T.

R.

Twp. Pool.
CORRECTED
 Co. Facet.

S-513-B

County Graham Elev. 2247' 2250'
 Sec. 24 Twp. 7 Rge. 23
 Company: Imperial
 Farm Name Fabricuis "B" No. 1

TOPS	DEPTH	LOG	DATUM
Anh.	1888		
Tp.			
H.	3456		
Tr.	3481		
Dg.			
B.L.			
L.	3498		
K.C.			
B.K.C.			
Ce.			
C.			
M.			
M.			
K.			
Mz.			
Mq.			
V.			
S.			
S.			
A.			
R.			
Pf.			
G.			
T.D.	3705		

Loc. in Sec. _____
C SW SE
 Geol. _____
 Contr. _____
 Pool _____
Fabricuis

COMPLETE " 27 '58 6	
----------------------------------	--

Date Comm. 7-14-58
 Ell @ 227 w/175, Drlg. 1220 JUL 23 '58 DST
3518 - 43 1hr 20'M BHP1150 DST 3634
- 48 2hr g/2hrs TSTM 1440' oil
BHP1220 DST 3650 - 69 1hr 1500
gip 1873 oil BHP1170 DST
3663 - 3705 1hr 8'M BHP0 no log
5 1/2 3704/100 wocT JUL 30 '58 ~
AUG 18 '58 8/3645-47 16/3652-56
to 8 BOPh 5 hrs NW rat (A) \$30

Co. _____
 Lse. _____
 No. _____
 Sec. _____
 T. _____
 R. _____

BOPHWW Inv. 2700' 0" B / 6
 \$ 10 BOPH 8 hrs 1300' 0" B
 \$ 18.75 BOPH 1500' 0" B PDP

AUG 13 '58

AUG 20 '58

AUG 27 '58

Draw down pump 1268 BOPD
 NW Lsg 3645-56

24-7-23W

CSWSE