
Graham KANSAS

SECTION 24 TOWNSHIP 7S RANGE 23W

WELL NO. #1 Lindley

COMPANY Imperial Oil

NORTH C SE SW

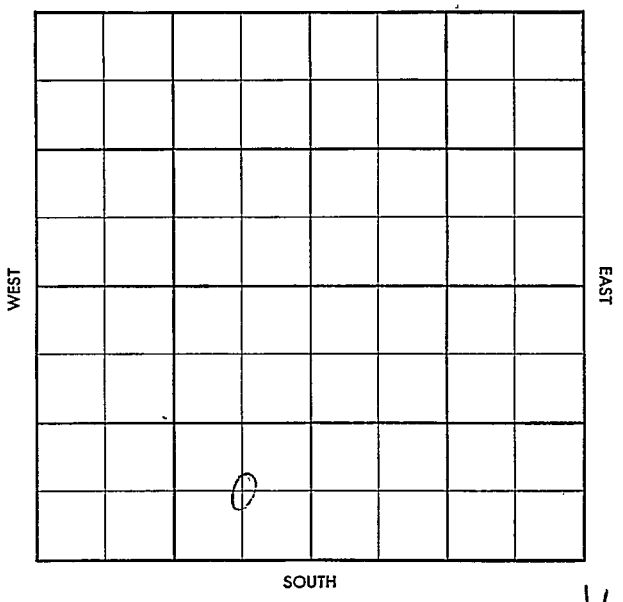

14

FORM 504-3 SUNRAY

Twp. X Pool X

Gr. X Facet. 5

S—513-B

County Graham Elev.

Sec. 24 Twp. 7 Rge. 23W

Company Imperial Oil

Farm Name Lindley No. 1

TOPS	DEPTH	LOG	DATUM
Anh.	1918		
Tp.			
H.			
Tr.			
Dg.			
B.L.			
L.			
K.C.			
B.K.C.			
Ce.			
C.			
M.			
M.			
K.			
Mz.			
Mq.			
V.			
S.			
S.			
A.			
R.			
Pf.			
G.			
T.D.			

Loc. in Sec. C SE SW

Geol.

Contr. Co. Tools #1

Pool ~~Fabricuis~~

FIRST REPORT


JL 9 '58

o

Date Comm. 7-8-58

8" @ 229 w/150, Drlg. 2580.

Co. Lse. No. Sec. T.

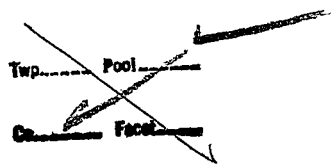

S-513-B

County Graham Elev. 2275DF 2278RB

Sec. 24 Twp. 7 Rge. 23W

Company Imperial Oil

Farm Name Lindley No. 1

TOPS	DEPTH	LOG	DATUM
Anh.	1918		
Tp.			
H.	3483		
Tr.	3508		
Dg.			
B. L.			
L.	3525		
K.C.			
B.K.C.	3720		
Ce.			
C.			
M.			
M.			
K.			
Mz.			
Mq.			
V.			
S.			
S.			
A.			
R.			
Pf.			
G.			
T.D.	3725		

Loc. in Sec. C SE SW

Geol.

Contr. Co. Tools #1

Pool Fabricuis

COMPLETE
AUG 20 '58

Date Comm. 7-8-58

8" @ 229 w/150, Drlg. 2580. JUL 16 '58 DST 3634-63 1hr 12'M BHP 1010/30" DST 3657-72 2hrs. 750 gip 60' Hocm 210 MO BHP 1180/20" DST 3669-93 2hrs 9/30" TSTM 3450' CO BHP 1230/20" DST 3688-3725 op 30" 10'M BHPO 5½" 3725/100 JUL 23 '58 JUL 30 '58 8/3672-74 (½) $ aver 8.5 BOPH

Co. Lse. No. Sec. T. R.

FORM 5131 SUNRAY

NW 3 hrs 1 $ aver 5 BOph NW
12 hrs 76/3682-86 $ 6 BOph
NW 24 hrs 16/3682-86 1/2
$ 5 BOph NW 9 hrs A $ 18 BOph
NW 10 hrs tstg AUG 6 '58 $ 33 BOph Thru
New POP AUG 13 '58 AUG 20 '58 Phy Pot
1494 BOPD NW
B Csg 3622-86
TD 3725

24-T-23W C Sec SW