FORM 51 10M 7-48 PETROL


KANSAS Rooks

Section 24 Township 7 Range 20W

Well No. 1 Carlton

Company D.G. Hansen

Wildcat

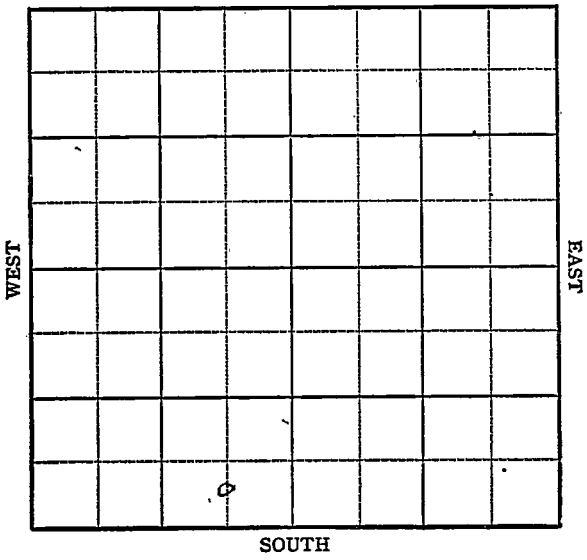

14

FORM 252-A
5M 4-48 PETROL

KANSAS Rooks V

Sec. 24 Twp. 7 R. 20W

Well No. #1 Carlton Farm

D. G. Hansen Company

Wildcat


_____ Ft. from N. Line

330' Ft. from S. Line

660' Ft. from E. Line

_____ Ft. from W. Line

C S L SE SW

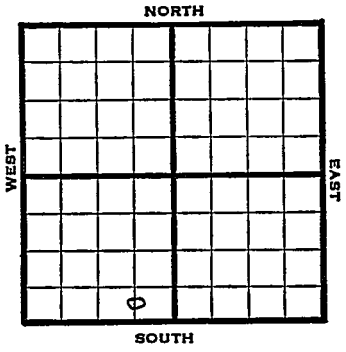

1948	Elev. 1992' REPORT
8/18	Location
8/25	RUR
9/1	8" @ 150' Drlg. 1540'
9/8	Lans 3192' Arb 3460' TD 3513'
	ABANDONED

Form 27—100 Bks.—4-48—Petrol

Rooks County Kansas State

Map No. Sec. 24 Twp. 7 R. 20W


Well No. 1 Carlton

D. G. Hansen Company

FIRST REPORT Contractor

C S L SE SW

SECTION PLAT

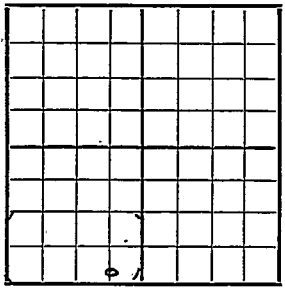

Ft. from N. Line

330 Ft. from S. Line

660 Ft. from E. Line

Ft. from W. Line

Wildcat

Remarks:

Location

Date AUG 1 8 1948

Scout S. J. LEWIS

Form 27—100 Bks.—4-48—Petrol

Rooks County Kansas State

Map No. 65 Sec. 24 Twp. 7 R. 20W

Well No. 1 Carlton


D. G. Hansen Company

ABANDONED Contractor

C S L SE SW

E1. 1992

SECTION PLAT

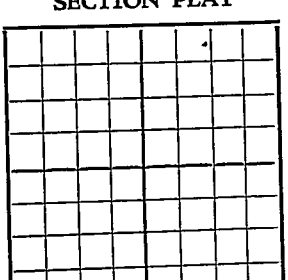

____ Ft. from N. Line

330 Ft. from S. Line

660 Ft. from E. Line

____ Ft. from W. Line

Wildcat

Remarks:

Lans 3192

Cer 8460

KCC 8513

Date SEP 8 1948

Scout S. J. LEWIS