


Graham

KANSAS

SECTION 25 TOWNSHIP 7S RANGE 23W

WELL NO. #1 Fabricuis

COMPANY Imperial Oil Co.

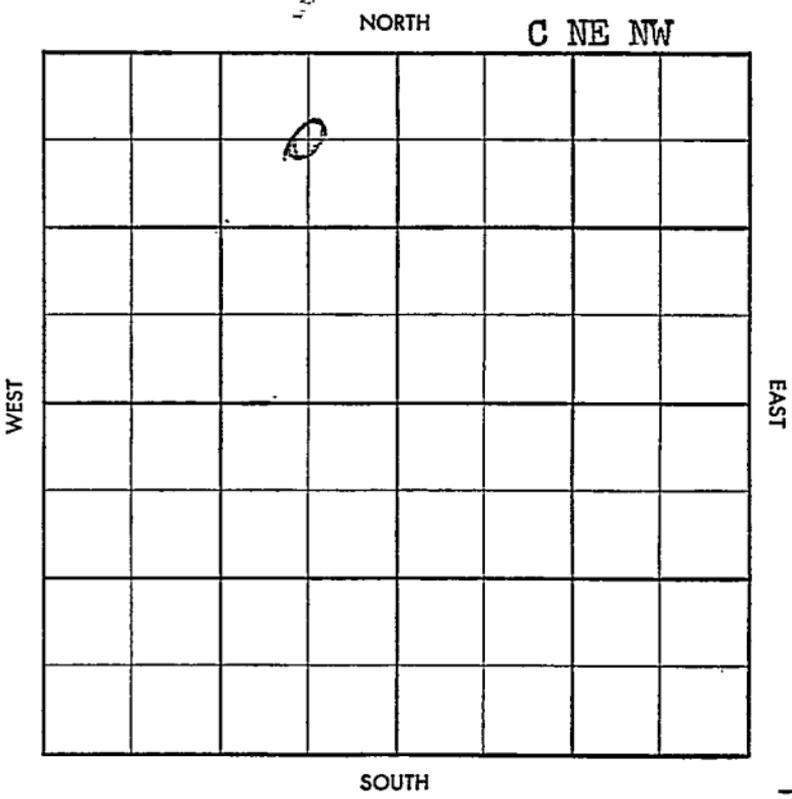

3

Top N Pool N

# WILDCAT

8B-N

S-513-B

County Graham Elev. \_\_\_\_\_  
 Sec. 25 Twp. 7 Rge. 23W  
 Company Imperial Oil Co.  
 Farm Name Fabricuis No. 1

| TOPS   | DEPTH | LOG | DATUM |
|--------|-------|-----|-------|
| Anh.   |       |     |       |
| Tp.    |       |     |       |
| H.     |       |     |       |
| Tr.    |       |     |       |
| Dg.    |       |     |       |
| B.L.   |       |     |       |
| L.     |       |     |       |
| K.C.   |       |     |       |
| B.K.C. |       |     |       |
| Ce.    |       |     |       |
| C.     |       |     |       |
| M.     |       |     |       |
| M.     |       |     |       |
| K.     |       |     |       |
| Mz.    |       |     |       |
| Mq.    |       |     |       |
| V.     |       |     |       |
| S.     |       |     |       |
| S.     |       |     |       |
| A.     |       |     |       |
| R.     |       |     |       |
| Pf.    |       |     |       |
| G.     |       |     |       |
| T.D.   |       |     |       |

Loc. in Sec. C NE NW

Geol. \_\_\_\_\_  
Contr. Co. Tools #3

Pool Wildcat

0

**FIRST REPORT**  
MAR 19 58

Date Comm. WORT

Co. \_\_\_\_\_  
Use. \_\_\_\_\_  
No. \_\_\_\_\_  
Sec. \_\_\_\_\_  
T. \_\_\_\_\_  
R. \_\_\_\_\_

Twp. X Pool X  
 Co. X Facet X  
**CORRECTION**

BR

S-513-B

County Graham Elev 2248 OF 223100  
 Sec. 25 Twp. 7 Rge 23W  
 Company Imperial Oil Co.  
 Farm Name Fabricuis No. 1

| TOPS      | DEPTH | LOG | DATUM | Loc in Sec.  |   |           |          |
|-----------|-------|-----|-------|--|---|-----------|----------|
| Anh.      | 1874  |     |       | CNE NW   |   |           |          |
| Tp.       |       |     |       |  |   |           |          |
| H.        | 3448  |     |       |  |   |           |          |
| Tr        | 3471  |     |       |  |   |           |          |
| Dg.       |       |     |       |  |   |           |          |
| B.L.      |       |     |       | Geol.  |   |           |          |
| L.        | 3490  |     |       | Contr.   |   |           |          |
| K.C.      |       |     |       | Co. Tools #3   |   |           |          |
| B.K.C.    | 3689  |     |       | Pool <u>Fabricuis</u>  |   |           |          |
| Ce.       |       |     |       | <u>Wildcat</u>   |   |           |          |
| C.        |       |     |       | <table border="1"> <tr> <td>0</td> </tr> <tr> <td>MAY 21 58</td> </tr> <tr> <td>COMPLETE</td> </tr> </table> | 0 | MAY 21 58 | COMPLETE |
| 0         |       |     |       |  |   |           |          |
| MAY 21 58 |       |     |       |  |   |           |          |
| COMPLETE  |       |     |       |  |   |           |          |
| M.s       |       |     |       |  |   |           |          |
| M.        |       |     |       |  |   |           |          |
| K.        |       |     |       |  |   |           |          |
| Mz.       |       |     |       |  |   |           |          |
| Mq.       |       |     |       |  |   |           |          |
| V.        |       |     |       |  |   |           |          |
| S.        |       |     |       |  |   |           |          |
| S.        |       |     |       |  |   |           |          |
| A.        | 3846  |     |       |  |   |           |          |
| R.        |       |     |       |  |   |           |          |
| Pf.       |       |     |       |  |   |           |          |
| G.        |       |     |       |  |   |           |          |
| T.D.      | 3890  |     |       |  |   |           |          |

Date Comm. 3-20-58  
 WORL MAR 25 58 8" 223/150 02950  
 APR 2 58 DST 3513-310p 2hrs rec 1m BHP  
 1305 DST 3552-80 0p2hrs 250' SW BHP  
 1120 DST 3603-250p 120" rec 35' VSOCM  
 BHP 940 DST 3622-42 0p60" 300' gip  
 rec 60' Hocm 60' oil BHP 1230 DST 3639  
 -58 g/60" rec 1900' oil BHP 1355 DST  
 3657-75 0p 60" 5' M BHP 905 DST 3852-61  
 0p 60" rec 5' M BHP 20 Eng Log APR 9 58

Co.  
Lst.  
No.  
Sec.  
T.  
R.

5" 3890 8/3637-38

B 290 + 29 MW net 16/3648  
-50 FU 400' oil in 45"

4 1/2 BO ph NW 6 hrs A 8

4 2 1/2 BO ph NW 8 hrs 9.0

5 BO ph NW 6 hrs pop APR 15 '58

APR 23 '58 APR 30 '58 MAY 7 '58 MAY 14 '58 MAY 21 '58

~~Play~~ Bottom Hole Bomb  
2969 BO NW