
FORM 51 25M 8-50 WESTERN Graham KANSAS

Section 26 Township 7 Range 22W

Well No. #1.Zeeman (C)

Company Murfin & Appleman

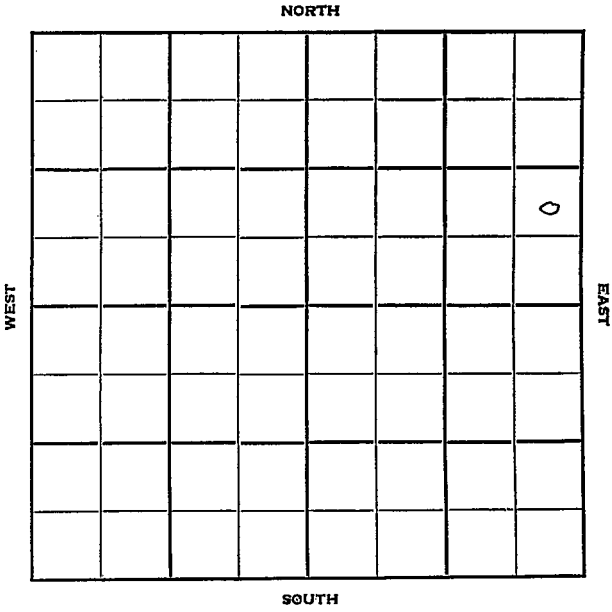

8

FORM 252-B
10M 8-51 TPCO. Graham KANSAS

Sec. 26 Twp. 7 R. 22W

Well No. #1 Zeeman (C) Farm

Murfin & Appleman Company

Contractor


Ft. from N. Line

990 Ft. from S. Line

330 Ft. from E. Line

Ft. from W. Line

NE SE NE

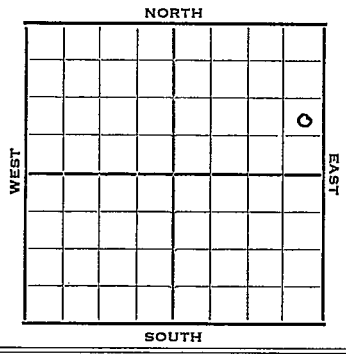

1952	Elev. 2243' REPORT
3/5	Location
3/12	"
3/19	WOR
3/25	8" @ 156' Drlg. 915'
4/1	Drlg. 2360'
4/9	Heeb. 3443 Dodge 3466
	Lans. 3480
	DST 3660-72, 1½ hr. 110' muddy sw
	1180# Drlg. ahead
4/16	Spud 3-18-52
	D & A TD 3891' 8" @ 156
	Heeb 3443' Dodge 3466' Lans. 3480'
	DST 3660-72 open 1½ hr. rec 110' muddy
	SW B KC 3676' Conng. 3770' Re-Arb
	3779'. Arb. 3879'.
	TD 3891' D & A
	ABANDONED

FORM 275 FOR SALE BY KANSAS BLUE PRINT CO.


County Graham State Kansas

Sec. 26 (Blk. Twp.) 7 (Sur. Rge.) 22W Map No.

Operator Murfin & Appleman

Well No. 1 Farm Zeeman (C)

Elev. Location NE SE NE

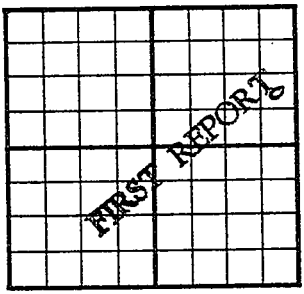

990 Ft. From S Line NE

330 Ft. From E Line Quarter

1st. Report MAR 5 1952

Completion

Remarks

Spudding Date

Drlg. Data

Location

J. G. McGEHEE

FORM 275 FOR SALE BY KANSAS BLUE PRINT CO.


County Graham State Kansas

Sec. 26 (Blk. Twp.) 7 (Sur. Rge.) 22W Map No.

Operator Murfin & Appleman

Well No. 1 Farm Zeeman "C"

Elev. 2243 Location NE SE NE

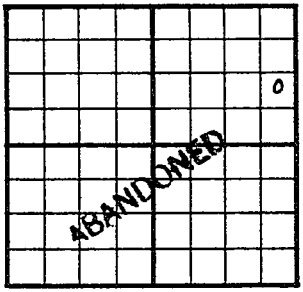

990 Ft. From S Line NE

330 Ft. From E Line Quarter

1st. Report

Completion APR 1 6 1952

Remarks

Spudding Date 3-18-52

Drlg. Data D & A TD 3891

8" @ 156 Heeb. 3443 Dodge 3466

Lans. 3480 DST 3660-72 open 1½ hr.

Rec. 110' muddy sw B KC 3676

Cong. 3770 ReArb. 3779 Arb. 3879

TD 3891

D & A

J. G. McGEHEE