


KANSAS

Rooks county

Section 26 Township 7 Range 17-W

Well No. #1, Stebbins

Company Alkay Oil Company

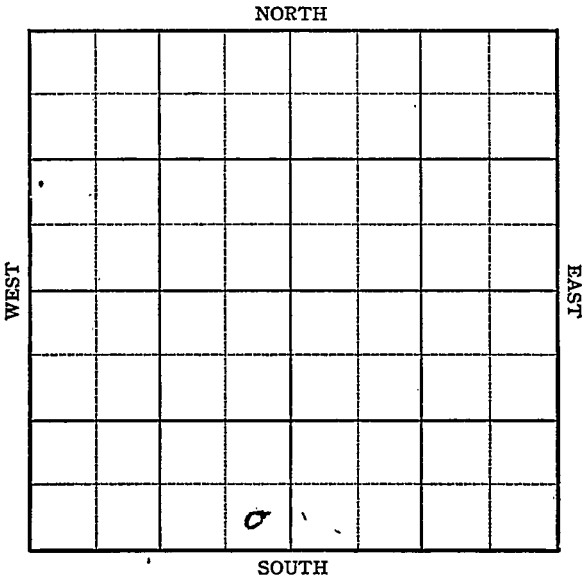

14

Sec. 26 Twp. 7 R. 17WWell No. #1 Stebbins FarmAlkay Oil

Company

Stockton


Ft. from N. Line

330 Ft. from S. Line

330 Ft. from E. Line

Ft. from W. Line

SE SW

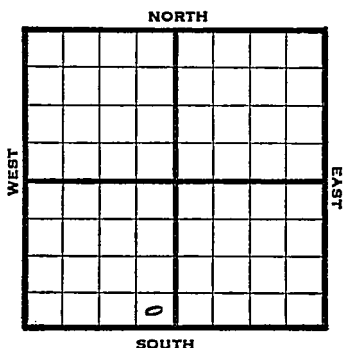

1946

1818

REPORT

9/18 Anhy 1151'
10" @ 1151' WOC

9/24 Topeka 2658
SO 2682-89 TD
7" @ 2682' RUST

10/1 " " "

10/8 1000 acid
SSO & W

10/15 " "

10/22 " "

10/29 " "

11/6 PB 2684 CO

11/12 " "

11/20 " "

11/27 Topeka 2658'
7" @ 2682'
TD 2689'
Pump 106 oil plus 40% water
27 Grav.

COMPLETED

KANSAS

Pool Name StocktonMap No. 64 Sec. 26 Twp. 7 R. 17WWell No. 1 StebbinsAlkay Oil


Company

FIRST REPORT

Contractor

SE SW

SECTION PLAT

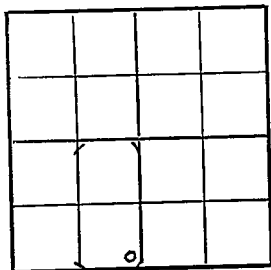

Ft. from N. Line

330 Ft. from S. Line330 Ft. from E. Line

Ft. from W. Line

Rooks County

Location

Rig up

Drilling and Remarks:

Anhy 1151'

10"@ 1151' WOC

RECORD

Cased _____ in., _____ ft.

Sand _____

Gas _____

Oil _____

Total Depth _____

PRODUCTION

1st 24 hrs. Nat. _____

1st 24 hrs. after shot _____

Gas _____ Cu. Ft.

Dry Hole _____

Abandoned _____

Date

SEP 1 8 1946 19

S. J. LEWIS

Scout

Kansas

Map No. 64 Sec. 26 Twp. 7 R. 17WWell No. 1 Stebbins


Alkay Oil

Company

COMPLETED

Contractor

SE SW

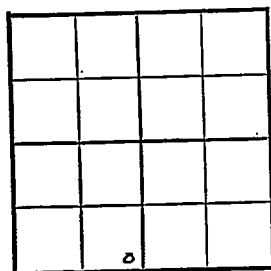E 11818
SECTION FLAT

Ft. from N. Line

330 Ft. from S. Line

330 Ft. from E. Line

Ft. from W. Line

Rooks County

Location

Rig up

Drilling and Remarks:

Dope ka 2658

7" C 2682

Pump 106 oil +
40% W.

279 1/2

RECORD

Cased _____ in., _____ ft.

Sand _____

Gas _____

Oil _____

Total Depth 2682

PRODUCTION

1st 24 hrs. Nat. _____

1st 24 hrs. after shot _____

Gas _____ Cu. Ft.

Dry Hole _____

Abandoned _____

Date,

NOV 27 1946

19

S. J. LEWIS

Scout