FORM 51 25M 3-49 PETROL KANSAS Graham

Section 27 Township 7 Range 22W

Well No. 1 Deprod

Company E.G. Hanson

Wildcat

NORTH

WEST

EAST

SOUTH

2

FORM 252-A
5M 10-48 PETROL

KANSAS Graham

Sec. 27 Twp. 7 R. 22W

Well No. #1 Deprod Farm

E. G. Hanson Company

Wildcat

330' Ft. from N. Line

Ft. from S. Line

~~990'~~ Ft. from E. Line

330 Ft. from W. Line

nw ne.

~~NW NE NE~~

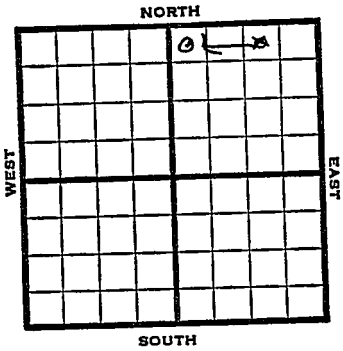

1949	Elev 2220' REPORT
4/27	Location
5/4	"
5/10	8"@ 201 Drlg 2025'
5/18	TD 3777' Lans. 3447' Arb. 3756' Aband.

ABANDONED

Form 26 200 Bks. 9-48 Petrol

Wildcat

Kansas

Map No. _____ Sec. 27 Twp. 7 R. 22W

Well No. 1 Deprod

E. G. Hanson Company

FIRST REPORT Contractor

NW NE NE

SECTION PLAT

330 Ft. from N. Line

_____ Ft. from S. Line

990 Ft. from E. Line

_____ Ft. from W. Line

Graham County

Location X

Rig up

Drilling and Remarks:

RECORD

Cased _____ in., _____ ft.

Sand

Gas

Oil

Total Depth

PRODUCTION

1st 24 hrs. Nat.

1st 24 hrs. after shot

Gas _____ Cu. Ft.

Dry Hole

Abandoned

Date

APR 27 1949 19

S. J. LEWIS Scout

Form 26 200 Bks. 9-48 Petrol

Wildcat

Kansas

Map No. K 66 Sec. 27 Twp. 7 R. 22W

Well No. 1 Deprod

E. G. Hanson Company

CORRECTION Contractor

NW NE ¼

SECTION PLAT

330 Ft. from N. Line

Ft. from S. Line

Ft. from E. Line

330 Ft. from W. Line

Graham County

Location

Rig up

Drilling and Remarks:

Reported

NW NE NE

RECORD

Cased in., ft.

Sand

Gas

Oil

Total Depth

PRODUCTION

1st 24 hrs. Nat.

1st 24 hrs. after shot

Gas Cu. Ft.

Dry Hole

Abandoned

Date

MAY 18 1949 19

S. J. LEWIS Scout

Form 26 300 Bks. 9-48 Petrol

Kansas

Wildcat

Map No. _____ Sec. 27 Twp. 7 R. 22W

Well No. 1 Deprod

E. G. Hanson Company

ABANDONED

Contractor

NW NE

El. 2225

SECTION PLAT

		0	

330 Ft. from N. Line

Ft. from S. Line

Ft. from E. Line

330 Ft. from W. Line

Graham County

Location

Rig up

Drilling and Remarks:

Lam 3447

Arb 3256.

RECORD

Cased in., ft.

Sand

Gas

Oil

Total Depth 3777

PRODUCTION

1st 24 hrs. Nat.

1st 24 hrs. after shot

Gas Cu. Ft.

Dry Hole

Abandoned

Date

MAY 18 1949 19

S. J. LEWIS Scout