

Section 27 Township 7 Range 19 WWell No. # 1 TaylorCompany B & R Drlg.

NORTH

					0		

WEST

EAST

SOUTH

2

Rooks

KANSAS

Sec. 27 Twp. 7 R. 19W

Well No. #1 Taylor Farm

B & R Drlg. Company

Contractor


330 Ft. from N. Line

_____ Ft. from S. Line

_____ Ft. from E. Line

990 Ft. from W. Line

NE NW NE

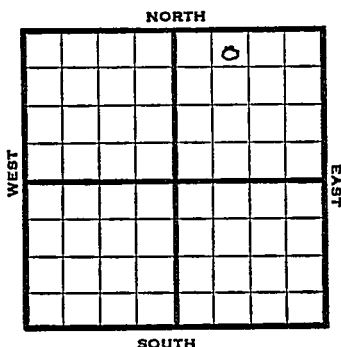

1952

Elev. 1952'

REPORT

3/12

Spud 3-10-52
Drlg.

3/18

8" @ 190
Anhy 1400
Drlg. 2962'

3/26

Spud 3-10-52
D&A TD 3433 8" @ 190
Anhy 1400 Top. 3074
Heeb. 3100 Tor. 3124
KC 3141
DST 3178-3205 open $\frac{1}{2}$ hr. rec. 10'
VSOCM DST 3309-21 open $\frac{1}{2}$ hr.
Rec. 4' clean oil 6' OCM 20'
drlg. mud B KC 3344 Marm. 3353
Cong. 3367 Arb. 3408
TD 3433' D&A

ABANDONED

County Rooks State KansasSec. 27 (Blk. 7 (Sur. 19W Map No. 19W)
(Twp.) (Rge.)Operator B & R Drlg.Well No. 1 Farm TaylorElev. _____ Location NE NW NE

FIRST REPORT

330 Ft. From N Line NE990 Ft. From W Line Quarter1st. Report MAR 12 1952

Completion _____


Remarks _____

Spudding Date 3-10-52

Drlg. Data _____

Drlg.J. G. MCGEHEE

County _____ Rooks _____ State Kansas
 Sec. 27 (Blk. 7) (Sur. 19W) Map No. _____
 Operator B & R Drlg.
 Well No. 1 Farm Taylor
 Elev. 1952 Location NE NW NE

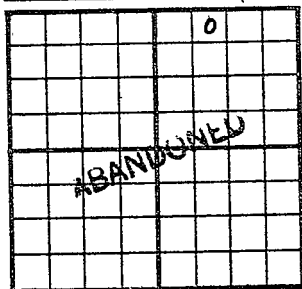

330 Ft. From N Line NE
990 Ft. From W Line Quarter

1st. Report

Completion MAR 26 1952

Remarks

Spudding Date 3-10-52

Drlg. Data D & A TD 3433

8" @ 190 Anhy 1400 Top. 3074

Heeb. 3100 Tor. 3124 KC 3141

DST 3178-3205 open $\frac{1}{2}$ hr. Rec. 10' vsocm

DST 3309-21 open $\frac{1}{2}$ hr. Rec. 4' clean

oil 6' ocm 20' drlg. mud B KC 3344

Marm. 3353 Cong. 3367 Arb. 3408

TD 3433

D & A

J. G. McGEHEE