
FORM 51 25M 3-49 PETROL

Books KANSAS

Section 27 Township 7 Range 20W

Well No. #1 Sample

Company B & R Drlg.

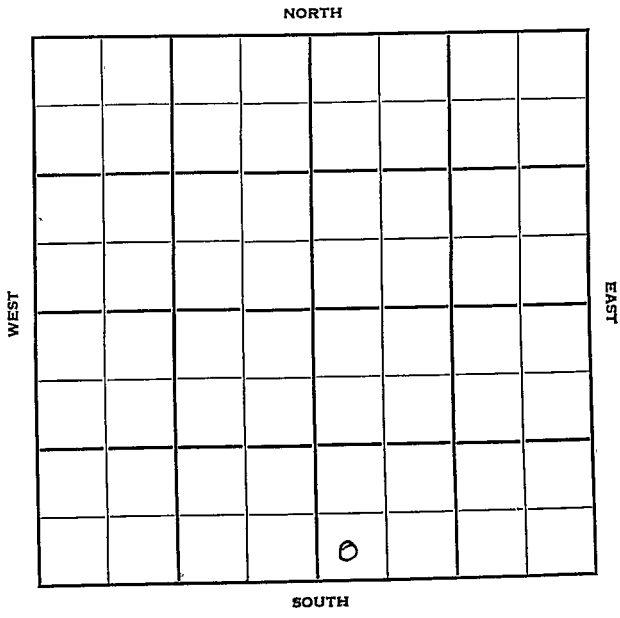

15

FORM 252-B
10M 9-49 PETROL

Rooks KANSAS

Sec. 27 Twp. 7 R. 20W

Well No. #1 Sample Farm

B & R Drlg. Company

Contractor

Wildcat


Ft. from N. Line

330' Ft. from S. Line

Ft. from E. Line

330' Ft. from W. Line

SW SW SE

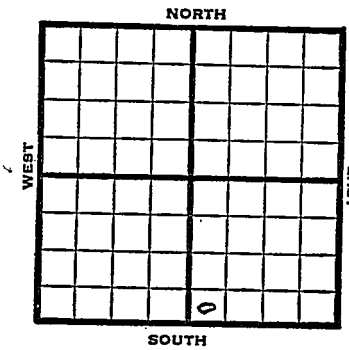

1950	Elev. 1995' REPORT
1/25	Spud 1-19-50 8" @ 183' Anhy. 1570' Drlg. 2264'
2/15	TD 3530' 8"@ 183' 5"@ 3320' Topeka 2986' Heeb 3175' Lans 3216' Arb. 3475' No shows D&A Aband.

ABANDONED

Form 26 200 Bks. 6-49 Petrol Kansas Wildcat

Map No. Sec. 27 Twp. 7 R. 20W


Well No. 1 Sample

B & R Drlg. Company

Contractor

SW SW SE El. 1995

SECTION PLAT

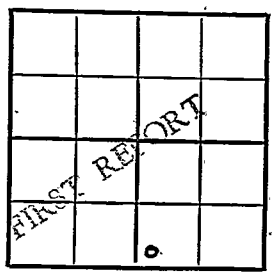

Ft. from N. Line

330 Ft. from S. Line

Ft. from E. Line

330 Ft. from W. Line

Rooks County

Location

Rig up

Drilling and Remarks:

Spud 1-19-50
8" @ 183
Anhy 1570
drlg. 2264

RECORD

Cased in., ft.

Sand

Gas

Oil

Total Depth

PRODUCTION

1st 24 hrs. Nat.

1st 24 hrs. after shot

Gas Cu. Ft.

Dry Hole

Abandoned

Date

JAN 25 1950 19 J. E. TYRA Scout

Form 26 200 Bks. 11-49 Petrol

Kansas Wildcat

Map No. _____ Sec. 27 Twp. 7 R. 20W

Well No. 1 Sample


B & R Drlg. Company

Contractor

SW ST SE

El. 1995

SECTION PLAT

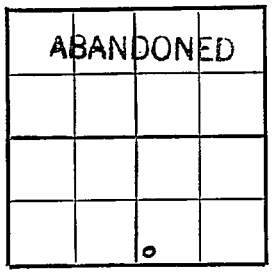

_____ Ft. from N. Line

330 Ft. from S. Line

_____ Ft. from E. Line

330 Ft. from W. Line

Rooks County

Location _____

Rig up _____

Drilling and Remarks:

8" @ 183

5" @ 3320

Topeka 2986

Reb 3175

Lans 3216

Arb 3475

No Shows

D+A.

RECORD

Cased _____ in., _____ ft.

Sand _____

Gas _____

Oil _____

Total Depth 3530

PRODUCTION

1st 24 hrs. Nat. _____

1st 24 hrs. after shot _____

Gas _____ Cu. Ft.

Dry Hole _____

Abandoned _____

Date

FEB 15 1950

19 _____

J. E. TYRA Scout