
Graham KANSAS

SECTION 28 TOWNSHIP 7 S RANGE 25 W

WELL NO. # 4 McFadden "B"

COMPANY ~~C.S.O. & Colo O & G~~

NE SE NE

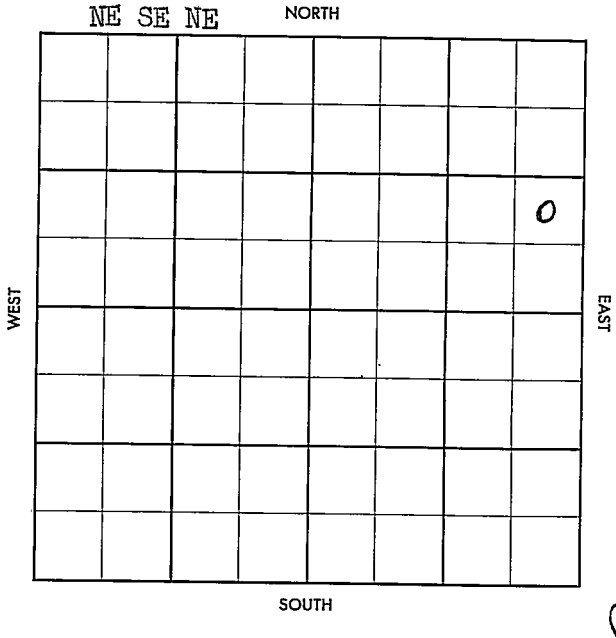

8

FORM 504-3 SUNRAY

FORM 513 SUNRAY

County Graham Elev.

Sec. 28 Twp. 7 Rge. 25W

Company C.S.O. & Colo. O. & G.

Farm Name McFadden No. 4

TOPS	DEPTH	LOG	DATUM
Anh.			
T.P.			
H.			
Tr.			
Dg.			
B.L.			
L.			
K.C.			
B.K.C.			
Ce.			
C.			
M.			
M.			
K.			
Mz.			
Mo.			
V.			
S.			
S.			
A			
R.			
P€.			
G.			
T.D.			

Loc. in Sec. NE SE NE

Geol.

Contr. Peel Tools

Pool Blazier


FIRST REPORT

AUG 28 '57

Date Comm.

M I R T

Co. Lse. No. Sec. T. R.

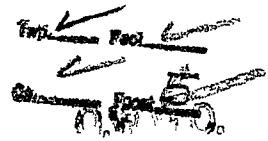

S-513-B

County Graham Elev. 2536 DF

Sec. 28 Twp. 7 Rge. 25W

Company C. S. O.

Farm Name McFadden "B" No. 4

TOPS	DEPTH	LOG	DATUM
Anh.			
Tp.			
H.			
Tr.			
Dg.			
B.K. Dodge	3654		
L.	3669		
K.C.			
B.K.C.			
Ce.			
C.			
M.			
M.			
K.			
Mz.			
Mq.			
V.			
S.			
S.			
A.			
R.			
Pf.			
G.			
T.D.			

Loc. in Sec. NE SE NE

(O.W.WO.)

Geol.

Contr.

Pool

FIRST REPORT

AUG 27 '56

Date Comm.

OLD INFO: Tops P. 27 BOPD from LKC

NEW INFO: Perf. L-KC, P 15 BO Plus 10 BWPD

Co. Lse. No. Sec. T. R.

FORM 513 SUNRAY

County Graham Elev. 2536 DF

Sec. 28 Twp. 7 Rge. 25W

Company C.S.O. & Colo. O. & G.

Farm Name McFadden "B" No. 4

TOPS	DEPTH	LOG	DATUM
Anh.	2145		
T.P.			
H.			
Tr. Dodge	3654		
Dg.			
Bl.			
L.	3669		
K.C.			
B.K.C.			
Ce.			
C.			
M.			
M.			
K.			
Mz.			
Mo.			
V.			
S.			
S.			
A			
R.			
P€.			
G.			
T.D.	3885		

Loc. in Sec. NE SE NE

Geol.

Contr. Peel Tools

Pool Blazier

OCT 2 '57

COMPLETE

Date Comm.

MIRT SEP 4 8-27-57 8 5/8

240/225 DST 3699-3725 1hr.

42' MCSW BHP 1200, 30 SEP 11 '57

DST 3733-66 30" 23" SLIGHT

CMBH 900/30" DST 3776-3885'

1hr rec 630' G 80' HOCM R/HP

1600/30" IFST 3525-55 30"

15' HOCM BH 240/30"

5½ 3884 MICT SEP 18 '57

Co. Lse. No. Sec. T. R.

FORM 513-1 SUNRAY

41/ 3843-53 37/ 3824-33
32/ 3759-97 3) P 8BO
6BW 17 hrs test
SEP 25 '57 DC - '57

27BO NW 24 hrs.
27°gr
Lcg 3759-3853

28-7-25W ne se ne