

Graham


KANSAS

SECTION 28 TOWNSHIP 7 RANGE 25 W

WELL NO. #1 McFadden

COMPANY Cities Service & Colorado O & G

NORTH

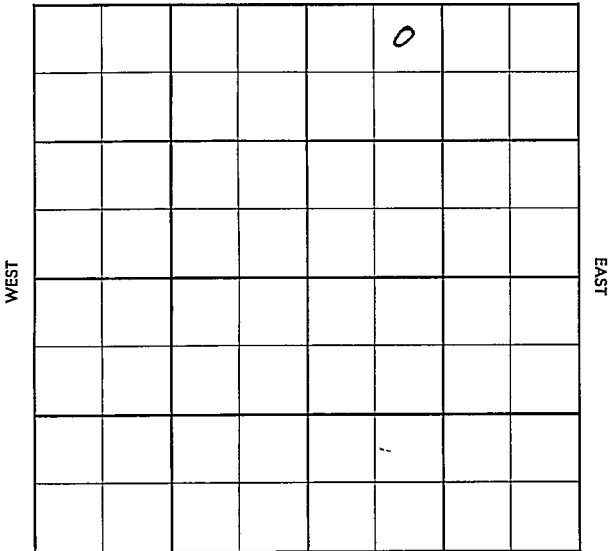

SOUTH

2

Graham

KANSAS

SEC.	28	TWP.	7	R.	25W
------	----	------	---	----	-----

WELL NO.

#1 McFadden 'B'

FARM

COMPANY

Cities Service & Colorado O & G

CONTRACTOR

Glenn Peel

Blazier


_____ Ft. from N. Line

_____ Ft. from S. Line

_____ Ft. from E. Line

_____ Ft. from W. Line

NE NW NE

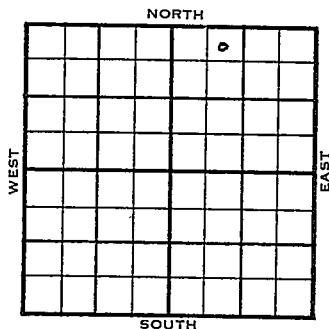

1955

ELEVATION

2528'

REPORT

10/19

Loc

12-7

Comm. 10-22-55

8 5/8" @ 238/225

DST 3674-80 op 1 hr. rec. 350' gco,
90' smco, 1265/30"DST 3680-3712 op 1 hr. rec. 64' ocm
980/30"DST 3714-28 op 1 hr. rec. 1855' geo
360' smco, 1150/30"DST 3757-75 op 1 hr. rec. 270' gco
390' smco, 955/30"DST 3775-3810 op 1 hr. rec. 8' socm
480' m&gco, 60' hocm, 1155/30"DST 3823-35 op 1/2 hr. rec. 16' mud
130/30"

5 1/2" @ 3865/175

CO to 3846 , 42/ 3758-78,

FU 190' oil 8 hr. 1000 A,

S/ 18.37 BOPH, 8 hr.,

Comp. 253 bopd.

Tp. 3411

H. 3606

Dodge 3626

L. 3645

BKC 3853

T.D. 3865'

COMPLETED

County Graham Elev. 2528
 Sec. 28 Twp. 7 Rge. 25W
 Company Cities Service & Colorado O & G
 Farm Name McFadden "B" No. 1

TOPS	DEPTH	LOG	DATUM	Loc. in Sec.
Ank.				
Tp.	<u>3411</u>		<u>883</u>	NE NW NE
H.	<u>3606</u>		<u>1078</u>	
Tr. <u>Dodge</u>	<u>3626</u>		<u>1098</u>	
Dg.				
Bl.				
L.	<u>3645</u>		<u>1117</u>	Geol.
K.C.				Contr.
B.K.C.	<u>3853</u>		<u>1325</u>	Glenn Peel
Ce.				Pool
C.				Blazier
M.				
M.				
K.				
Mz.				
Me.				
V.				
S.				
S.				
A.				
R.				
Pe.				
G.				
T.D.	<u>3865</u>			COMPLETED

Date Comm. 10-22-55 DEC 7 1955

8 5/8" @ 238/225 DST 3674-80 open 1 hr

rec. 350' gco 90' smco 1265/30"

DST 3680-3712 open 1 hr. rec. 64' ocm

980/30" DST 3714-28 open 1 hr.

rec. 1855' gco 360' smco 1150/30"

DST 3757-75 open 1 hr. rec. 270' gco

390' smco 955/30" DST 3775-3810

open 1 hr. rec. 8' socm 480' m & gco

60' hocom 1155/30" DST 3823-35

open $\frac{1}{2}$ hr. rec. 16' mud 130/30"

5 $\frac{1}{2}$ " @ 3865/175 CO to 3846 42/ 3758-78

FU 190' oil 8 hr. 1000 A S/ 18.37 boph

8 hr. Comp. 253 bopd

R. G.

DEC 15 1955