
OWWO Graham Kansas

SECTION 28 TOWNSHIP 7 S RANGE 25 W

WELL NO. # 4 McFadden "B"

COMPANY C.S.O.

NORTH NE SE NE

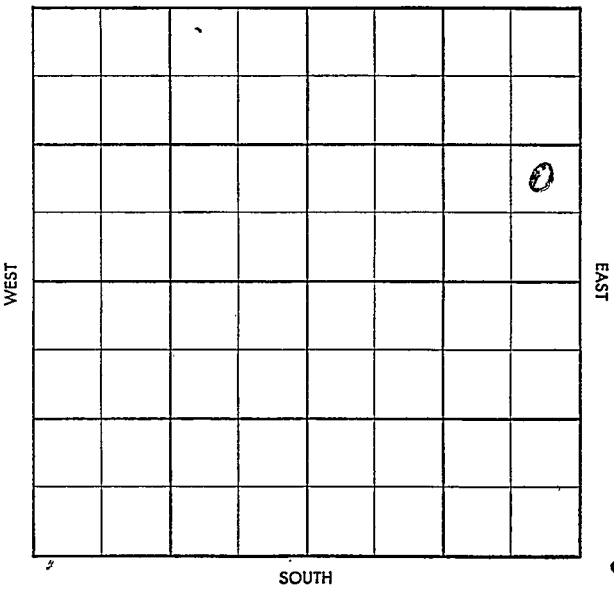

8

FORM 504-3 SUNRAY

C.W.W.O.

S-513-B

County Graham · Elev. 2536 DF

Sec. 28 Twp. 7 Rge. 25W

Company C. S. O.

Farm Name McFadden "B" No. 4

TOPS	DEPTH	LOG	DATUM
Anh.			
Tp.			
H.			
Tr.			
Do. Dodge	3651		
B.L.	3669		
L.			
K.C.			
B.K.C.			
Ce.			
C.			
M.			
M.			
K.			
Mz.			
Mq.			
V.			
S.			
S.			
A.			
R.			
Pf.			
G.			
T.D.	3885		

Loc. in Sec. NE SE NE

(C.W.W.O.)

Geol. C.W.W.O.

Contr.

Pool

SEP 10 '58

COMPLETE

Date Comm.

OLD INFO: TopsP. 27 BOPD from LKC

NEW INFO: Perf. L-KC, P 15 BO Plus 10

BWPD SEP 3 '58 SEP 10 '58 5" 3884

Phy P 27 BO 3799 - 3853

new / 3793 - 56 1500 H

P 15 BO BW Pd

Co. Lse. No. Sec. T. R.