

KANSAS

Rooks

Section 28 Township 7 Range 19WWell No. 1 CrammCompany Harry GoreWildcat
NORTH

				0			

WEST


EAST

SOUTH

2

Sec. 28 Twp. 7 R. 19W ✓Well No. #1 Cramm FarmHarry Gore Company

Wildcat

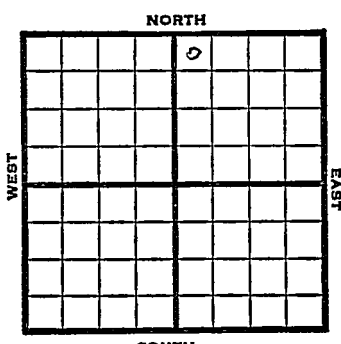330' Ft. from N. Line Ft. from S. Line Ft. from E. Line330' Ft. from W. Line

NW NE

SOUTH

1949 Elv. 1976' REPORT

3/30	Location	
4/6	Surface hole	
4/12	8" @ 183'	
	Drlg 2770'	
4/20	Lansing 3158'	
	Arbuckle 3417-25'	
	TD 3425'	
	5" @ 3418'	
4/27	TD 3472'	
	PB 3397'	
	48 shots 3347-56	
	½ bbl oil PH 500 acid	
5/4	500 acid	
	Swb 46 bbls oil lin 16 hrs.	
5/10	"	
5/18	"	
5/25	"	
6/1	"	
6/7	"	
6/15	"	
6/22	Lans. 3158'	Arb 3417'
	5" @ 3418'	1976
	Perf Lans	1441
	500 acid	
	Pump 66 oil Pot.	
	Grav. 28°	
	TD 3472'	

COMPLETED

Kansas

Map No. _____ Sec. 28 Twp. 7 R. 19W

Well No. 1 Cramm

Harry Gore

Company

FIRST REPORT

Contractor

NW NE


SECTION PLAT

330 Ft. from N. Line

Ft. from S. Line

Ft. from E. Line

330 Ft. from W. Line

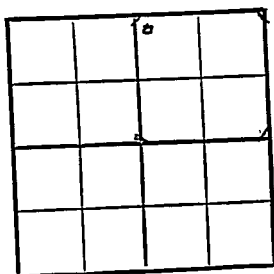

Rooks County

Location X

Rig up

Drilling and Remarks:

RECORD

Cased _____ in., _____ ft.

Sand _____

Gas _____

Oil _____

Total Depth _____

PRODUCTION

1st 24 hrs. Nat. _____

1st 24 hrs. after shot _____

Gas _____ Cu. Ft.

Dry Hole _____

Abandoned _____

Date

MAR 30 1949

19

S. J. LEWIS

Scout

Kansas

Map No. K65 Sec. 28 Twp. 7 R. 19WWell No. 1 Cramm

Harry Gore

Company

COMPLETE

Contractor

NW NE

E11926
SECTION PLAT330 Ft. from N. Line Ft. from S. Line Ft. from E. Line330 Ft. from W. Line

Rooks County

RECORD

Location Rig up

Drilling and Remarks:

*Line 318**283417**5" @ 3418**Pay Line**500 ac**Pay 660 oil Pt*Cased in., ft.Sand Gas Oil Total Depth 3422

PRODUCTION

1st 24 hrs. Nat. 1st 24 hrs. after shot Gas Cu. Ft.Dry Hole Abandoned

Date

JUN 22 1949

19

S. J. LEWIS

Scout