

Section 28 Township 7 Range 19W

Well No. 2 Cramm

Company Harry Gore

NORTH

							0

WEST

EAST

SOUTH

1

Rooks

KANSAS

Sec. 28 Twp. 7 R. 19 W

Well No. # 2 Gramm Farm

Harry Gore Company

Semi-Wildcat Contractor


330 Ft. from N. Line

 Ft. from S. Line

•330 Ft. from E. Line

 Ft. from W. Line

NE NE NE

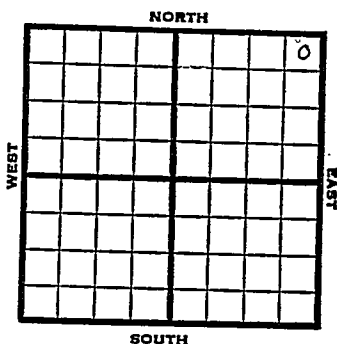

1951

Elev. 1920'

REPORT

7/25

Spud 7-18-51
8" @ 185'
Anhy 1428'
Drlg. 2560'

8/15

Spud 7-18-51
D & A TD 3422' 8" @ 185'
Anhy 1428' Top. 2863' Heeb 3067'
Dodge 3082' Lans 3096'
DST 3245-90 open 1 hr. rec 245' OCM
DST 3295-3335 open $\frac{1}{2}$ hr. rec 30' mud
Arb. 3380-91 5" @ 3384' TD 3391'
DD 3395' 500 A SSO DD 3422'
HFW PB 3365' 24/3322-28 2000 A
S/ 12 BWPH PB 3290' 12/3282-86
2000 A S/16 BWPH
D & A

ABANDONED

County Rooks State Kansas

Sec. 28 (Blk.) 7 (Sur.) 19W Map No.

Operator **Harry Gore**

Well No. 2 Farm Cramm

Elev.	1920	Location	NE NE NE
-------	------	----------	----------

[illegible]

330 Ft. From N Line NE

330 Ft. From T₁ Line Quarter

1st. Report JUL 25 1951

Completion

Remarks

Spudding Date **7-18-51**

Drbg. Data

Semi Wildcat

8" @ 185 Arhy 1428 drlg. 2560

~~J. E. TYRA~~

County Rooks State Kansas
 Sec. 28 (Blk. 7) (Sur. 19W) Map No.

Operator Harry Gore

Well No. 2 Farm Cramm

Elev. 1920 Location NE NE NE

						0

ABANDONED

330 Ft. From N Line NE

330 Ft. From E Line Quarter

1st. Report

Completion AUG 15 1951

Remarks Semi Wildcat

Spudding Date 7-18-51

Drig. Data D & A TD 3422

8" @ 185 Anhy 1428 Top. 2863

Heeb. 3067 Dodge 3082 Lans. 3096

DST 3245-90 open 1 hr. Rec. 245' ocm

DST 3295-3335 open $\frac{1}{2}$ hr. Rec. 30' mud

Arb. 3380-91 5" @ 3384 TD 3391

DD 3395 500 A SS0 DD 3422 HFW

PB 3365 24/ 3322-28 2000 A S/ 12 bwph

PB 3290 12/ 3282-86 2000 A S/ 16 bwph

D & A

J. E. TYRA