KANSAS


Form 51—5M—7-40—Palace

Graham

Section 29 Township 7 Range 22-W

Well No. 1 Boller

Company Gulf

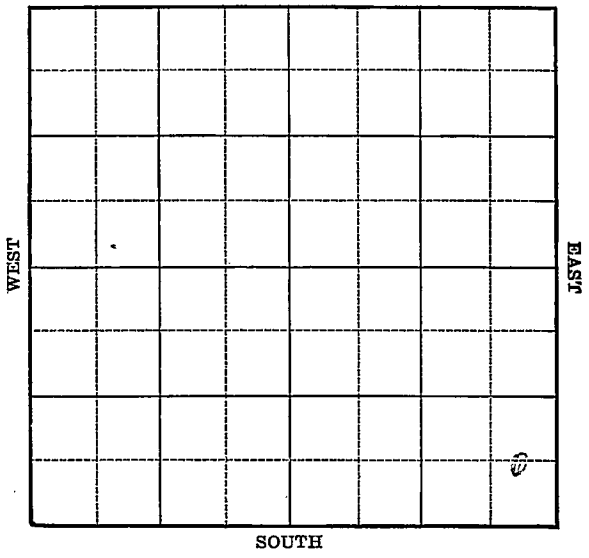

16

FORM 252-A 5M 2-40 KANSAS Graham

Sec. 29 Twp. 7 R. 22-W

Well No. #1 Boller Farm

Gulf Company


(Wildcat)

____ Ft. from N. Line

66.0 Ft. from S. Line

330 Ft. from E. Line

____ Ft. from W. Line

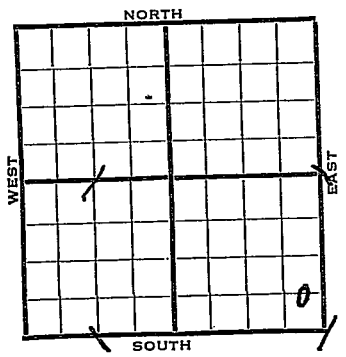

Elev. 2264

1941	REPORT
1/15	Cellar.
1/23	13" - 493' T.D. 503' WOC.
1/30	Drlg. 3336'
2/6	Anhy 1875' Drlg. 3858'
2/6	Ft. Riley 2480 Neva 2800 Tarkio 3129
	Topeka 3272 Lansing 3520
	Base K.C. 3718 No Cong. Arb. 3837
	Core 3855-58½ Full recovery
	Extremely porous heavily saturated
	with black oil TD 3858½
	Running 5" 3837 (Tel)
2/13	Arb. 3837-58½' T.D. 5" - 3838'
	RUST. S. heavy black oil.
2/20	Drlg. 3890' 2800' water.

OVER

1941
2/26 Lans. 3520'
B.K.C. 3718'
5" - 3838'
Arb. 3837'
T.D. 3901'
H.F.W.

ABANDONED

Form 26—200 Bks.—1-40—Palace Graham KANSAS

Map No. 66 Sec. 29 Twp. 7 R. 22W

Well No. 1 Boller

Gulf Company

Contractor

FIRST REPORT

C E L SE SE

Ft. from N. Line


660 Ft. from S. Line

330 Ft. from E. Line

Ft. from W. Line

WILDCAT

SECTION PLAT

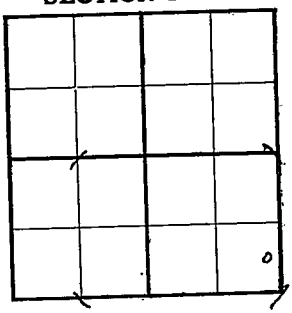

Location

Rig up

Drilling and Remarks:

Cellar

RECORD

Cased in., ft.

Sand

Gas

Oil

Total Depth

PRODUCTION

1st 24 hrs. Nat.

1st 24 hrs. after shot

Gas Cu. Ft.

Dry Hole

Abandoned

Date

JAN 15 1941 19

S. J. LEWIS Scout

Form 26—200 Bks.—1-40—Palace Graham KANSAS

Map No. 66 Sec. 29 Twp. 7 R. 22W

Well No. 1 Boller

Gulf Company

ABANDONED Contractor

C E L SE SE

____ Ft. from N. Line


660 Ft. from S. Line

330 Ft. from E. Line

____ Ft. from W. Line

WILDCAT

SECTION PLAT

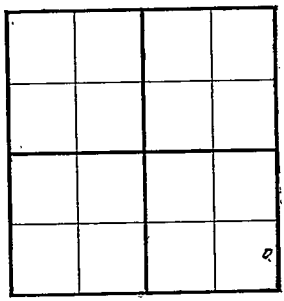

Location ____

Rig up ____

Drilling and Remarks:

Lans 3520
BKC 3718
5" C 3838
Arb 3832
HPW.

RECORD

Cased ____ in., ____ ft.

Sand ____

Gas ____

Oil ____

Total Depth 3901

PRODUCTION

1st 24 hrs. Nat. ____

1st 24 hrs. after shot ____

Gas ____ Cu. Ft.

Dry Hole ____

Abandoned ____

Date

FEB 26 1941 19

S. J. LEWIS Scout