


Section 3 Township 7 Range 26W

Well No. 1 O. S. Allen

Company Empire Drlg.

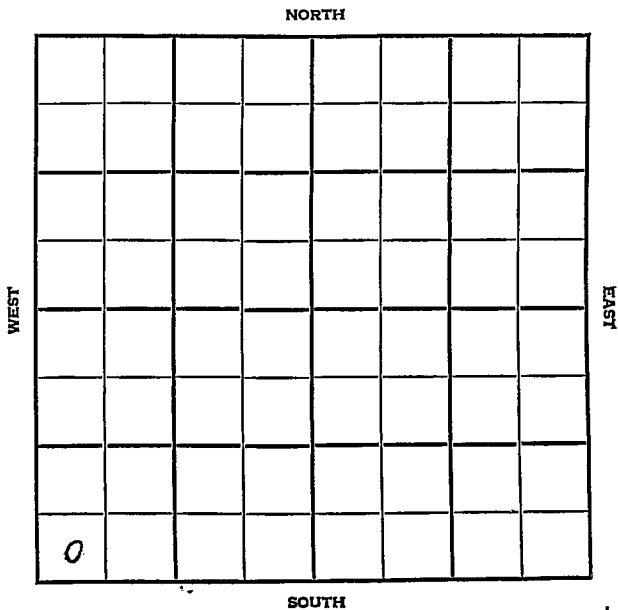

13

Sheridan

KANSAS


SEC.	TWP.	R.
3	7	26 W

WELL NO. # 1 O. S. Allen FARM  
 COMPANY

CONTRACTOR Empire Drlg.

Wildcat

\_\_\_\_\_ Ft. from N. Line  
 330 \_\_\_\_\_ Ft. from S. Line  
 \_\_\_\_\_ Ft. from E. Line  
 330 \_\_\_\_\_ Ft. from W. Line

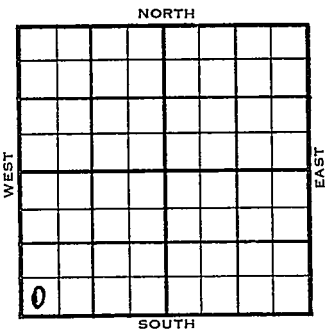

SW SW SW

NCRA - DHM

	ELEVATION	REPORT
1955	2587'	

3/9

Spud 3-6-55  
 8" @ 324 WOC

3/16

Spud 3-6-55 D&A TD 4011  
 8" @ 324 Anhy 2276, Heeb 3753  
 Tor. 3777, KC 3791, B KC 3991,  
 TD 4011,  
 D&A

**ABANDONED**



