
FORM 51 25M 8-50 WESTERN Graham KANSAS

Section 30 Township 7 Range 21W

Well No. #1 Fabricius

Company Deep Rock Oil

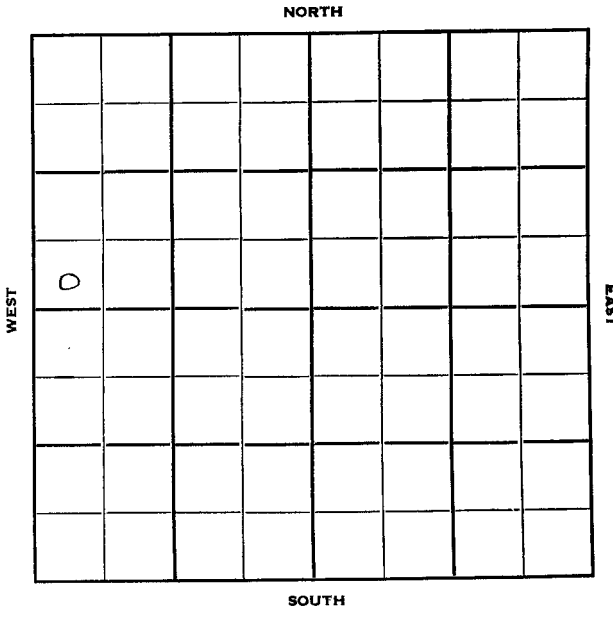

5

FORM 252-B
10M 11-50 PETROL

Graham

KANSAS

Sec. 30 Twp. 7 R. 21 W

Well No. # 1 Fabricius Farm

Deep Rock Oil Company

Creekmore Drlg. Contractor


Ft. from N. Line

330 Ft. from S. Line

Ft. from E. Line

330 Ft. from W. Line

SW SW NW

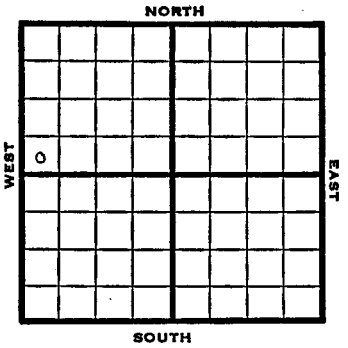

1951

Elev. 2201' REPORT

9/5
9/26

Location
Spud 9-13-51
D&A TD 3845
8" @ 300'
Anhy 1761'
DST 3340-58' open 1 hr.
Rec. 810' gcw
Lans. 3408'
DST 3410-66 open 1 hr.
Rec. 2115' sw
Cong. 3712' Arb. 3730'
DST 3730-34 open 1 hr.
Rec. 15' mud
DST 3734-42 open 1 hr.
Rec. 39' mud
DST 3742-82 open ½ hr.
Rec. 60' mud
DST 3780-3845 open ½ hr.
Rec. 820' sw
TD 3845'
D&A

ABANDONED

FORM 275 FOR SALE BY KANSAS BLUE PRINT CO.


County Graham State Kansas

Sec. 30 (Blk. Twp.) 7 (Sur. Rge.) 21W Map No.

Operator Deep Rock Oil

Well No. 1 Farm Fabricius

Elev. Location SW SW NW

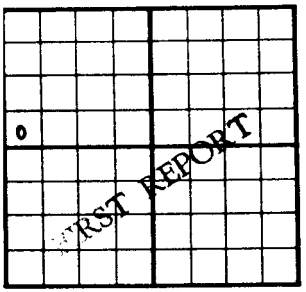

330 Ft. From S Line NW

330 Ft. From W Line Quarter

1st. Report SEP 5 1951

Completion

Remarks Creekmore Drlg. - Contr.

Spudding Date

Drlg. Data

Location

J. E. TYRA

FORM 275 FOR SALE BY KANSAS BLUE PRINT CO.


County Graham State Kansas

Sec. 30 (Blk. Twp.) 7 (Sur. Rge.) 21W Map No.

Operator Deep Rock Oil

Well No. 1 Farm Fabricius

Elev. 2201 Location SW SW NW

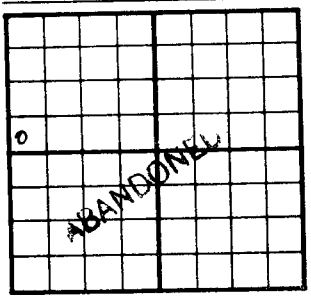

330 Ft. From S Line NW

330 Ft. From W Line Quarter

1st. Report

Completion SEP 2 6 1951

Remarks

Creekmore Drlg. - Contr.

Spudding Date 9-13-51

Drlg. Data D & A TD 3845

8" @ 300 Anhy 1761 DST 3340-58

open 1 hr. Rec. 810' gcw Lans. 3408

DST 3410-66 open 1 hr. Rec. 2115' sw

Cong. 3712 Arb. 3730 DST 3730-34

open 1 hr. Rec. 15' mud DST 3734-42

open 1 hr. Rec. 39' mud DST 3742-82

open $\frac{1}{2}$ hr. Rec. 60' mud DST 3780-3845

open $\frac{1}{2}$ hr. Rec. 820' sw TD 3845

D & A

J. E. TYR