


KANSAS Graham

Section 30 Township 7 Range 22WWell No. 1 Hine zCompany Woodriver Oil & Ref.

Wildcat

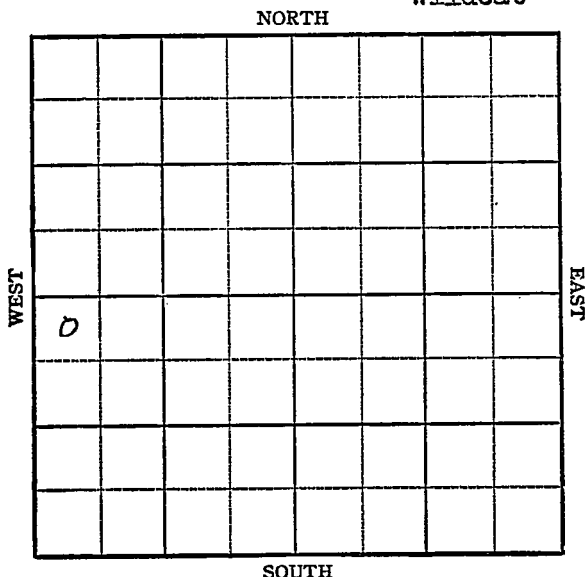

12

KANSAS Graham

Sec. 30 Twp. 7 R. 22-W ✓

Well No. #1 Hinez Farm

Woodriver Oil & Ref. Company

Wildcat


330 Ft. from N. Line

Ft. from S. Line

Ft. from E. Line

330 Ft. from W. Line

NW SW

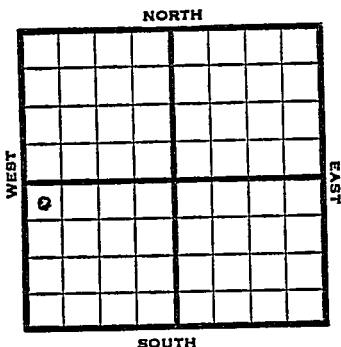

1948

R E P O R T

10/6

Location

10/13

8" @ 247'

Drlg 2135'

10/19

Lansing 3489'

BKC 3683'

Drlg 3740'

10/27

TD 3928'

Arb. 3853'

Aband.

**ABANDONED**

Map No. \_\_\_\_\_ Sec. 30 Twp. 7 R. 22W

Well No. 1 Hinez

Woodriver Oil & Ref. Company

# FIRST REPORT

Contractor

NW SW


## SECTION PLAT

330 Ft. from N. Line

\_\_\_\_\_ Ft. from S. Line

\_\_\_\_\_ Ft. from E. Line

330 Ft. from W. Line

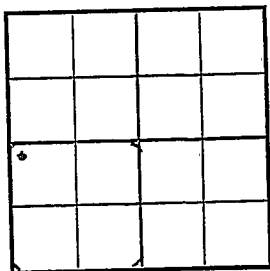

Graham County

Location X

Rig up \_\_\_\_\_

Drilling and Remarks:

## RECORD

Cased \_\_\_\_\_ in., \_\_\_\_\_ ft.

Sand \_\_\_\_\_

Gas \_\_\_\_\_

Oil \_\_\_\_\_

Total Depth \_\_\_\_\_

## PRODUCTION

1st 24 hrs. Nat. \_\_\_\_\_

1st 24 hrs. after shot \_\_\_\_\_

Gas \_\_\_\_\_ Cu. Ft.

Dry Hole \_\_\_\_\_

Abandoned \_\_\_\_\_

Date

OCT 6 1948 19 S. J. LEWIS Scout

Kansas

Map No. 66 Sec. 30 Twp. 7 R. 22WWell No. 1 HinezWoodriver Oil & Ref. Company**ABANDONED**

Contractor

NW SW

512227  
**SECTION PLAT**330 Ft. from N. Line       Ft. from S. Line       Ft. from E. Line330 Ft. from W. Line

|   |  |  |  |
|---|--|--|--|
|   |  |  |  |
|   |  |  |  |
| 4 |  |  |  |
|   |  |  |  |

Graham CountyLocation                     Rig up                     

Drilling and Remarks:

Per X3803**RECORD**Cased            in.,            ft.Sand                     Gas                     Oil                     Total Depth 3928**PRODUCTION**1st 24 hrs. Nat.                     1st 24 hrs. after shot                     Gas                      Cu. Ft.Dry Hole                     Abandoned                     

Date

OCT 27 194819S. J. LEWISScout