Graham


FORM 51

KANSAS

Section 30 Township 7 Range 24W

Well No. #1 Fox

Company Berwick Drlg. et al

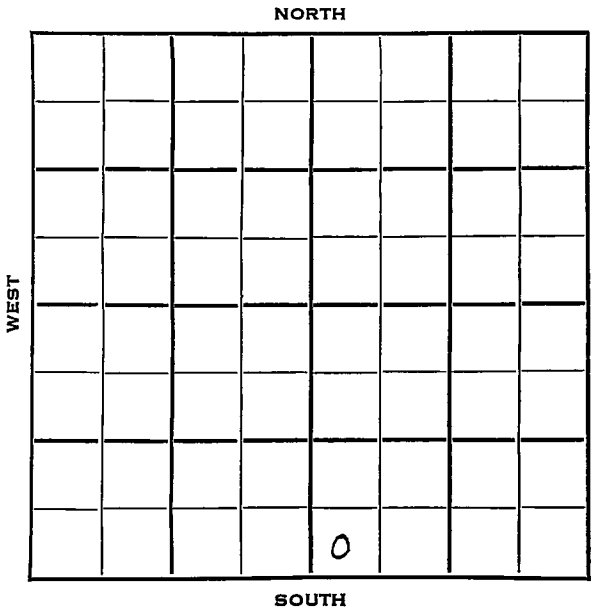

15

Graham KANSAS

SEC.	TWP.	R.
30	7	24 W

WELL NO. # 1 Fox FARM

COMPANY Berwick Drlg. et al

CONTRACTOR Berwick

Wildcat


_____ Ft. from N. Line

330 Ft. from S. Line

_____ Ft. from E. Line

330 Ft. from W. Line

SW SW SE

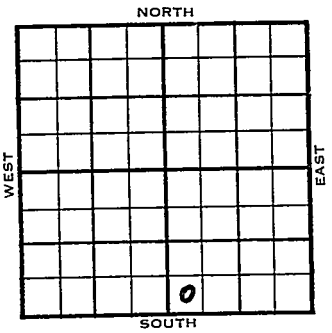

1953	ELEVATION 2436' REPORT
11/11	Location
11/18	8" @ 128
	Drlg. 2300'
12/2	Spud 11-12-53
	D&A
	TD 4360'
	8" @ 128'
	Anhy 2145', Heeb 3698', Lans 3739'
	DST 3892-3907', opn ½ hrs., rec. 5' mud
	70#
	B KC 3951', Cong 4188', Miss 4200',
	Viola 4221', Simp. 4299', Arb. 4329'
	TD 4360'
	D&A

ABANDONED

DX-78

FORM 275 FOR SALE BY KANSAS BLUE PRINT CO.


County Graham State Kansas

Sec. 30 (Blk. Twp.) 7 (Sur. Rge.) 24W Map No.

Operator Berwick Drlg. etal.

Well No. 1 Farm Fox

Elev. Location SW SW SE

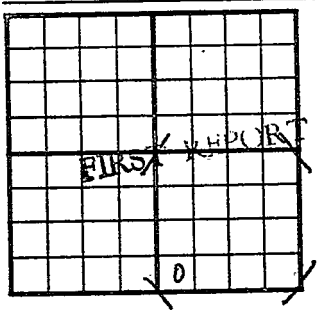

330 Ft. From S Line SE

330 Ft. From W Line Quarter

1st. Report NOV 11 1953

Completion

Remarks

Berwick - Contr.

Spudding Date

Drlg. Data Wildcat

Location

J. G. McGEHEE

FORM 275 FOR SALE BY KANSAS BLUE PRINT CO.


County Graham State Kansas

Sec. 30 (Blk. Twp.) 7 (Sur. Rge.) 24W Map No.

Operator Berwick Drlg. etal.

Well No. 1 Farm Fox

Elev. 2436 Location SW SW SE

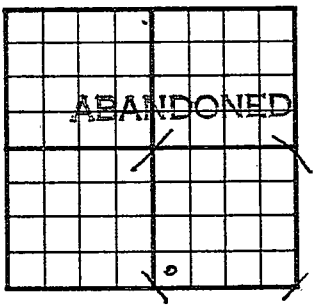

330 Ft. From S Line SE

330 Ft. From W Line Quarter

1st. Report

Completion Dec 2 1953

Remarks Wildcat

Berwick - Contr.

Spudding Date 11-12-53

Drlg. Data D & A TD 4360

8" @ 128 Anhy 2145 Heeb. 3698

Lans. 3739 DST 3892-3907 open ½ hr.

Rec. 5' mud 70# B KC 3951 Cong. 4188

Miss 4200 Viola 4221 Simp. 4299

Arb. 4329 TD 4360

D & A

J. G. McGEHEE