KANSAS


FORM 51 5M 1-42 PETROL

Graham

Section 31 Township 7 Range 21-W

Well No. #1 J. N. Wiesner

Company Hollow

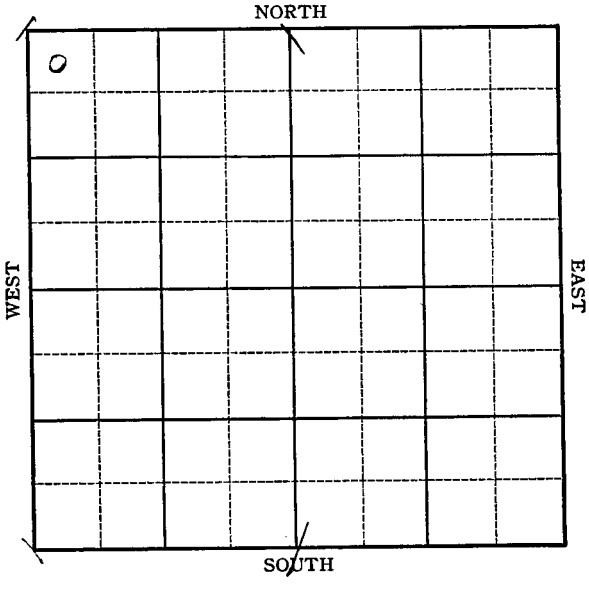

4

FORM 252-A
5M 9-42 GASS

KANSAS

Graham

Sec. 31 Twp. 7 R. 21 W

Well No. #1 J. N. Wiesner Farm

Hollow Company

Wildcat


330 Ft. from N. Line

Ft. from S. Line

Ft. from E. Line

330 Ft. from W. Line

Elev. 2194

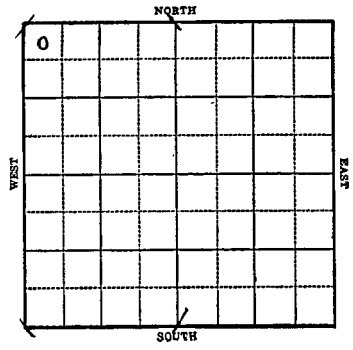

1943	REPORT
7/21	Location.
7/28	"
8/4	"
8/11	"
8/18	"
8/25	"
9/1	Surfaced hole
9/8	8" @ 203' Anhy 1770 Drlg. 2595'
9/15	Topeka 3165 Lans 3410 Drlg. 3470
9/22	Arb 3733 T.D. 3753

ABANDONED

Form 26 200 Bks 5-42 Petrol Graham

KANSAS

Map No. 65 Sec. 31 Twp. 7 R. 21W

Well No. 1 J. N. Wiesner

Hollow Company

FIRST REPORT

Contractor

NW/C

330 Ft. from N. Line


Ft. from S. Line

Ft. from E. Line

330 Ft. from W. Line

WILDCAT

SECTION PLAT

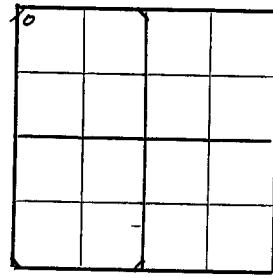

Location X

Rig up

Drilling and Remarks:

RECORD

Cased in., ft.

Sand

Gas

Oil

Total Depth

PRODUCTION

1st 24 hrs. Nat.

1st 24 hrs. after shot

Gas Cu. Ft.

Dry Hole

Abandoned

Date

JUL 21 1943 19 S. J. LEWIS Scout

Form 26 200 Bks 5-42 Petrol Graham

Map No. 65 Sec. 31 Twp. 7 R. 21W

Well No. 1 J. N. Wiesner

Hollow Company

ABANDONED Contractor

NW/C

330 Ft. from N. Line


____ Ft. from S. Line

____ Ft. from E. Line

330 Ft. from W. Line

Wildcat

SECTION PLAT

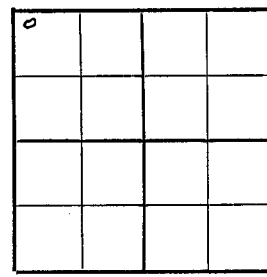

Location ____

Rig up ____

Drilling and Remarks:

AL Y 3283

RECORD

Cased ____ in., ____ ft.

Sand ____

Gas ____

Oil ____

Total Depth 2255

PRODUCTION

1st 24 hrs. Nat. ____

1st 24 hrs. after shot ____

Gas ____ Cu. Ft.

Dry Hole ____

Abandoned ____

Date

SEP 2 2 1943 19____ S. J. LEWIS Scout