

Section 31 Township 7 Range 10WWell No. #1 GasperCompany Texas Pacific Coal & Oil

NORTH

0							

WEST

EAST

SOUTH

12

Mitchell

KANSAS
10 W



Sec. 31 Twp. 7 R. 10

Well No. # 1 Gasper Farm

Texas Pacific Coal & Oil Company

Mallard Drlg. Contractor

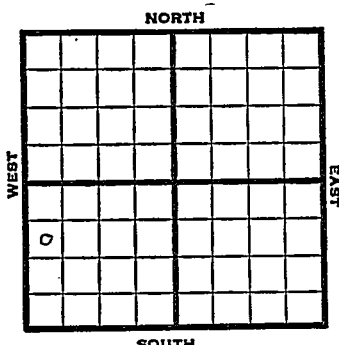
990 Ft. from N. Line

 Ft. from S. Line

 Ft. from E. Line

330 Ft. from W. Line

SW NW SW



1951

Elev. 1556' REPORT

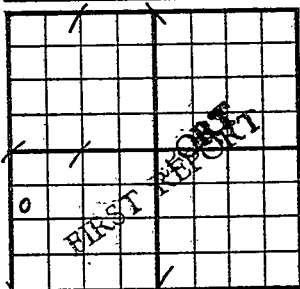
9/5

Spud 9-2-51
10" @ 205'
Drlg. 1048'

9/26

Spud 9-2-51
10" @ 205'
TD 3899'
Anhy 1103' Top. 2329
Miss 3337' Viloa 3585'
Arb. 3872-99 TD
D&A

ABANDONED

County Mitchell State KansasSec. 31 (Blk. Twp.) 7 (Sur. Rge.) 10W Map No.Operator Texas Pacific Coal & OilWell No. 1 Farm GasperElev. Location SW NW SW990 Ft. From N Line SW330 Ft. From N Line Quarter1st. Report SEP 5 1951

Completion

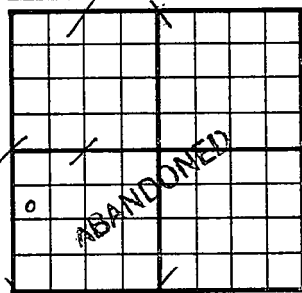
Remarks

Mallard Drlg. - Contr.Spudding Date 9-2-51

Drlg. Data

10" @ 205 drlg. 1048

J. E. TYRA

County Mitchell State KansasSec. 31 (Blk. Twp.) 7 (Sur. Rge.) 10W Map No.Operator Texas Pacific Coal & OilWell No. 1 Farm GasperElev. 1556 Location SW NW SW990 Ft. From N Line SW330 Ft. From W Line Quarter

1st. Report

Completion SEP 26 1951

Remarks

Mallard Drlg - Contr.Spudding Date 9-2-51Drlg. Data D & A TD 389910" @ 205 Anhy 1103 Top. 2329Miss. 3337 Viola 3585 Arb. 3872-99TDD & A

J. E. TYRA