

# KANSAS

FORM 51 5M 10-41 PETROL


Rooks

Section 31 Township 7 Range 17-W

Well No. #1 Roelfs

Company Threeway Prlg.

Wildcat

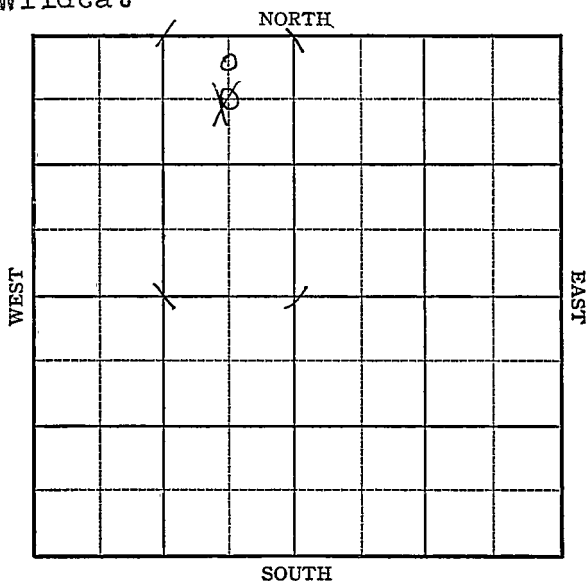

3

KANSAS

Rooks

Sec. 31 Twp. 7 R. 17-W

Well No. # 1 Roelfs Farm

Three way Drilling Company

Wildcat

330

~~660~~


Ft. from N. Line

Ft. from S. Line

660

Ft. from E. Line

Ft. from W. Line

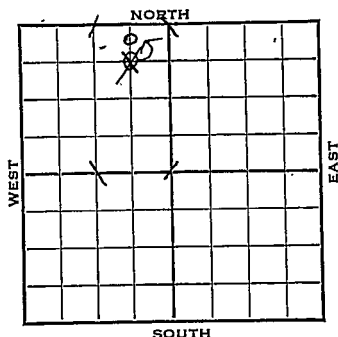

SOUTH

~~C NE NE~~

Elev. 1903

1942

REPORT

12/9

Loc.

12/16

"

12/22

Rotary

12/29

"

1943

1/6

Drlg. 1500' SD

1/13

Anhy 1277

Drlg. 2740'

1/20

Lams 3066

BKC 3321

Congl. 3365

Simp. Sh. 3422

Arb 3437

No Show

TD 3485'

ABANDONED

Map No. 64 Sec. 31 Twp. 7 R. 17WWell No. 1 Roelfs

Threeway Drilling Company

FIRST REPORT Contractor

C NE NW


660 Ft. from N. Line

Ft. from S. Line

660 Ft. from E. Line

Ft. from W. Line

## SECTION PLAT

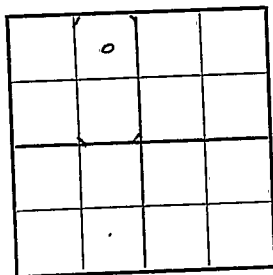

WILDCAT

Location XXX

Rig up

Drilling and Remarks:

## RECORD

Cased \_\_\_\_\_ in., \_\_\_\_\_ ft.

Sand \_\_\_\_\_

Gas \_\_\_\_\_

Oil \_\_\_\_\_

Total Depth \_\_\_\_\_

## PRODUCTION

1st 24 hrs. Nat. \_\_\_\_\_

1st 24 hrs. after shot \_\_\_\_\_

Gas \_\_\_\_\_ Cu. Ft.

Dry Hole \_\_\_\_\_

Abandoned \_\_\_\_\_

Date

DEC 9 1942 19

S. J. LEWIS

Scout

KANSAS

Map No. 64 Sec. 31 Twp. 7 R. 17WWell No. 1 Roelfs

Threeway Drilling \_\_\_\_\_ Company

CORRECTION \_\_\_\_\_ Contractor

C NL NE NW


330 Ft. from N. Line

\_\_\_\_\_ Ft. from S. Line

660 Ft. from E. Line

\_\_\_\_\_ Ft. from W. Line

## SECTION PLAT

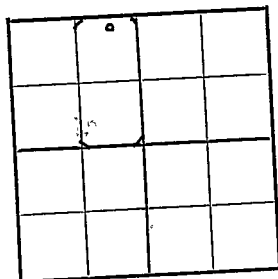

WILDCAT

Location \_\_\_\_\_

Rig up \_\_\_\_\_

Drilling and Remarks:

Reported C NE NE

## RECORD

Cased \_\_\_\_\_ in., \_\_\_\_\_ ft.

Sand \_\_\_\_\_

Gas \_\_\_\_\_

Oil \_\_\_\_\_

Total Depth \_\_\_\_\_

## PRODUCTION

1st 24 hrs. Nat. \_\_\_\_\_

1st 24 hrs. after shot \_\_\_\_\_

Gas \_\_\_\_\_ Cu. Ft.

Dry Hole \_\_\_\_\_

Abandoned \_\_\_\_\_

Date

DEC 29 1942 19

S. J. LEWIS Scout.

Rooks

KANSAS *64*  
 Map No. 15 Sec. 31 Twp. 7 R. 17W

Well No. 1 RoelfsThreeway Drilling Company

ABANDONED

Contractor

C NL NE NW

330 Ft. from N. Line         Ft. from S. Line660 Ft. from E. Line         Ft. from W. Line

## SECTION PLAT

|  |   |  |  |
|--|---|--|--|
|  | 0 |  |  |
|  |   |  |  |
|  |   |  |  |
|  |   |  |  |

WILDCAT

Location         Rig up         

Drilling and Remarks:

*Lane 3066**B/C 3321**Cong 3365**Shup 3422**Per 3437**No 4000*

## RECORD

Cased          in.,          ft.Sand         Gas         Oil         Total Depth 3485

## PRODUCTION

1st 24 hrs. Nat.         1st 24 hrs. after shot         Gas          Cu. Ft.Dry Hole         Abandoned         

Date

JAN 20 1943

19

S. J. LEWIS

Scout