


Thomas

KANSAS

Section 30 Township 7 Range 32W

Well No. #1 Thomas

Company Kelley & Weisbeck

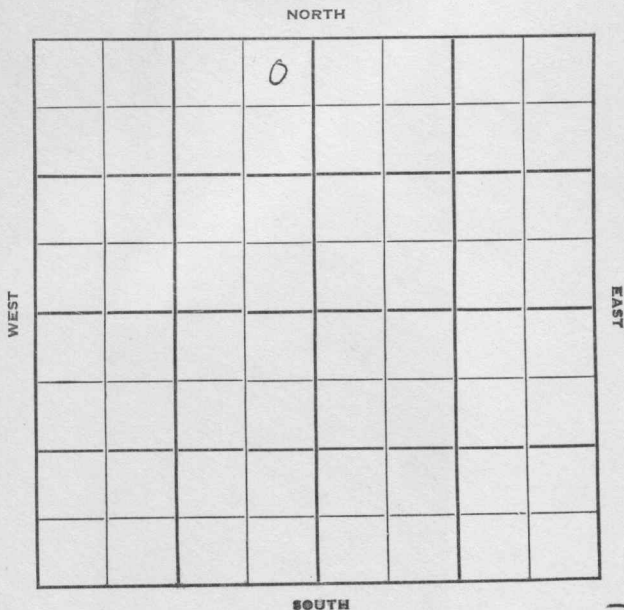

3

Kansas

Map No. _____ Sec. 30 Twp. 7 R. 32WWell No. 1 Thomas_____Kelley & Weisbeck_____
Company_____
Contractor

NE NE NW

SECTION PLAT

330 Ft. from N. Line_____
Ft. from S. Line330 Ft. from E. Line_____
Ft. from W. LineThomas County Westgate-Greenland

Location _____

Rig up _____

Drilling and Remarks:

Spud 4-30-50

Core drilled **RECORD** farmou

Cased _____ in., _____ ft.

Sand _____

Gas _____

Oil _____

Total Depth _____

PRODUCTION

1st 24 hrs. Nat. _____

1st 24 hrs. after shot _____

Gas _____ Cu. Ft.

Dry Hole _____

Abandoned _____

Date

MAY 3 1954J. E. TYRA

Scout

Map No. _____ Sec. 30 Twp. 7 R. 32WWell No. 1 ThomasKelley & Weisbech

Company

Contractor


NE NE NW

El. 3110
SECTION PLAT330 Ft. from N. Line

_____ Ft. from S. Line

330 Ft. from E. Line

_____ Ft. from W. Line

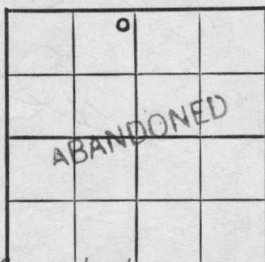Thomaswest gate Greenland
farmout on core drill

Location _____

Rig up _____

Drilling and Remarks:

8" @ 265
 Dakota 1692
 anky 2787
 Topeka 3839
 Keokuk 4085
 Lanes 4120

RECORD

Cased _____ in., _____ ft.

Sand _____

Gas _____

Oil _____

Total Depth 5261

PRODUCTION

1st 24 hrs. Nat. _____

1st 24 hrs. after shot _____

Gas _____ Cu. Ft.

Dry Hole _____

Abandoned _____

Date

(over)

MAY 31 1950

19

J. E. TYRA Scout

Thomas

Sec. 30 Twp. 7 R. 32W

Well No. #1 Thomas Farm

Kelley & Weisbeck Company

Contractor

Wildcat


330' Ft. from N. Line

Ft. from S. Line

330' Ft. from E. Line

Ft. from W. Line

NE NE NW

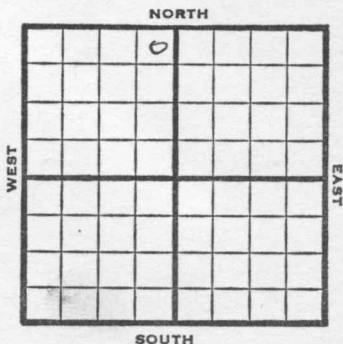

950 Elev. 3110' REPORT

5/3 Spud 4-30-50

5/31 8" @ 265'

Dakota 1692'

Anhy 2787'

Topeka 3839'

Heeb 4085'

Lans 4120'

TD 5261'

D&A

ABANDONED

BKC 4417'

Miss 4737'

Arb 4884'

Reagan 5229'