

Sec. 32 Twp. 7 R. 22W

Well No. #1 Jones Farm

Anderson-Prichard Company

Harmony Pool Contractor


_____ Ft. from N. Line

330 Ft. from S. Line

330 Ft. from E. Line

_____ Ft. from W. Line

SE SE SW

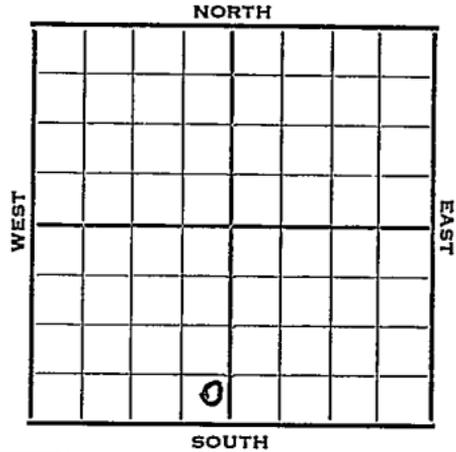

1953

Elev. 2131' REPORT

7/14

Location

7/22

8" @ 210 w/175
Drlg. 2495'

7/29

Anhy 1745, Top 3121, Heeb3323, Tor
3350, Lans 3364
DST 3413-45, 1 hr., 1045' SW, 1310#
DST 3522-35, 1 hr., 200' HOCM, 100'
MCO, 1140#
DST 3536-57, 1 hr., 75' M, 960#
Drlg. 3716'

8/5

NR

8/26

Spud 7-16-53 Oil well TD 3766
8" @ 210 Anhy 1745 Top 3121
Heeb 3323 Tor 3350 Lans 3364
DST 3413-45 open 1 hr rec 1045' SW
1310#
DST 3522-35 open 1 hr rec 200' HOCM
100' MCO 1140#
DST 3536-57 open 1 hr rec 75" mud 960#
ReArb. 3705 Arb. 3736 TD 3766
8" @ 3611 CO to 3580 30/3529-33
1/2 BOPH & SSW 500 A S/80 BO & SSW
16 hr. S/5 1/4 BOPH P/97 BOPD 1%
wtr. P/100 BOPD 1% wtr.
Comp. 148 BOPD

COMPLETED

