

Section 32 Township 7 Range 23 WWell No. # 1 MichaelisCompany Anshutz Drlg.

NORTH

							0

SOUTH

WEST

EAST

Graham

KANSAS

Sec. 32 Twp. 7 R. 23W ✓

Well No. #1 Michaelis Farm

Anschutz Drlg. Company

Contractor

Wildcat


330 Ft. from N. Line

_____ Ft. from S. Line

330 Ft. from E. Line

_____ Ft. from W. Line

NE NE NE

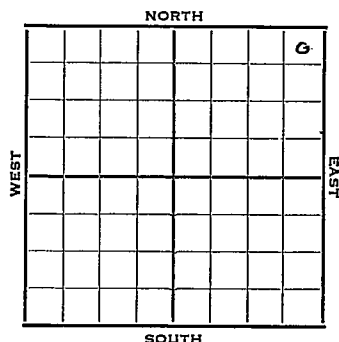

1952

Elev. 2391' REPORT

5/14

Location

5/20

8" @ 163

Anhy 2075

Drlg. 3050'

5/28

Spud 5-14-52

D & A TD 4180' 8" @ 163'

Anhy 2075' Howard 3310' Top 3340'

Heeb 3648' Tor. 3664' Lans. 3694'

B KC 3892' Marm 3912' Cong 4096'

Arb. 4148'

TD 4180' D & A

ABANDONED



Sec. **32** (Blk. **7** (Sur. **23W** Map No.

Well No. 1 Farm Michaelis

Elev.	Location	NE	NE	NE
-------	----------	----	----	----

FIRST REPORT

330 Ft. From N Line NE

330 Ft. From E Line Quarter

1st. Report MAY 14 1952

Completion _____

Remarks _____

Spudding Date _____

Drlg. Data Wildcat

Location

J. G. McGEHEE

County Graham State Kansas
 Sec. 32 (Blk.) 7 (Sur.) 23W Map No.
 Operator Anschutz Drlg.
 Well No. 1 Farm Michaelis
 Elev. 2391 Location NE NE NE

						0

330 Ft. From N Line NE
330 Ft. From E Line Quarter
 Ist. Report
 Completion MAY 28 1952
 Remarks Wildcat

Spudding Date 5-14-52

Drlg. Data D & A TD 4180

8" @ 163 Anhy 2075 Howard 3310

Top. 3340 Heeb. 3648 Tor. 3664

Lans. 3694 B KC 3892 Marm. 3912

Cong. 4096 Arb. 4148 TD 4180

D & A

J. G. McGEHEE