


Section 33 Township 7 Range 21W

Well No. #1 W.K.I.T. School

Company Keating Drlg.

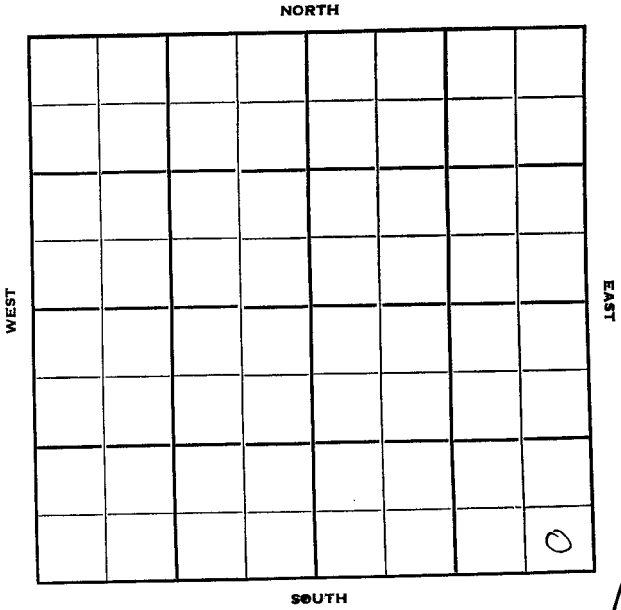

Sec. 33 Twp. 7 R. 21W

Well No. #1 W.K. I T. School Farm

Keating Drlg. Company

Keating Contractor
Wildcat

Ft. from N. Line


330 Ft. from S. Line

330 Ft. from E. Line

Ft. from W. Line

SE SE SE

Gulf-Support

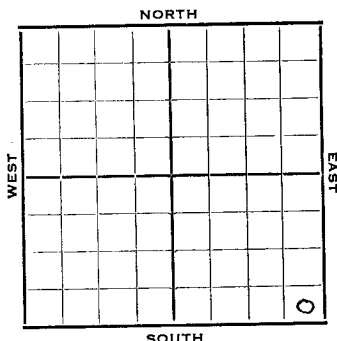

1952 Elev. 2065' REPORT

6/25 Spud 6-23-52
8" @ 189' WOC

7/2 Anhy 1670 Topeka 3076
Heeb. 3286 Tor 3307
Lans. 3321 Drlg. 3425'

7/9 Spud 6-23-52
D & A TD 3655' 8" @ 189
Anhy 1670' Top 3076' Heeb 3286'
Tor. 3307 Lans. 3321' B KC 3523'
Cong. 3583' Arb. 3616'
TD 3655' D & A

ABANDONED

County **Graham** State **Kansas**

Sec. **33** (Blk. **7** (Sur. **21W** Map No.

Operator Keating Drlg.

Well No. **1** Farm **W.K.I.T. School**

Elev.	Location	SE	SE	SE
-------	----------	----	----	----

FIRST REPORT

330 Ft. From **8** Line **SE**

330 Ft. From E Line Quarter

1st. Report **JUN 25 1962**

Completion

Remarks **Gulf - support**


Keating - Contr.

Spudding Date **6-23-52**

Drig. Data **Wildcat**

8" @ 189 WOC

J. G. McGEHEE

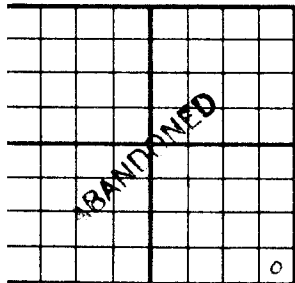County Graham State KansasSec. 33 (Blk. 7 (Sur. 21W Map No. 21W) (Twp.) (Rge.)Operator Keating Drlg.Well No. 1 Farm W.K.I.T. SchoolElev. 2065 Location SE SE SE330 Ft. From S Line SE330 Ft. From E Line Quarter

1st. Report

Completion JUL 9 1952Remarks WildcatKeating - Contr.Spudding Date 6-23-52Drlg. Data D & A TD 36558" @ 189 Anhy 1670 Top. 3076Heeb. 3286 Tor. 3307 Lans. 3321B KC 3523 Cong. 3583 Arb. 3616 TD 3655D & A

J. G. McGEHEE