
FORM 51 25M 8-50 WESTERN Graham KANSAS

Section 33 Township 7 Range 22 W

Well No. # 1 Morphew

Company D. G. Hansen

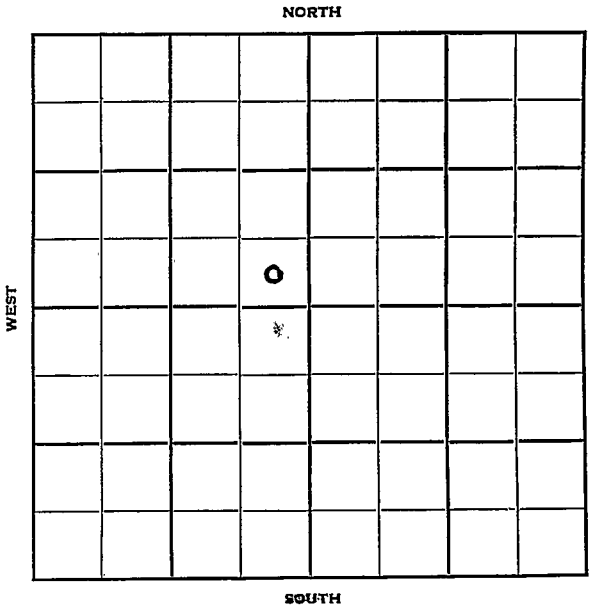

6

FORM 252-B
10M 8-51 TPCO.

Graham KANSAS ✓

Sec. 33 Twp. 7 R. 22 W

Well No. # 1 Morphew Farm

D. G. Hansen Company

C. & G. Drlg. Contractor

Wildcat


Ft. from N. Line

330 Ft. from S. Line

330 Ft. from E. Line

Ft. from W. Line

SE SE NW

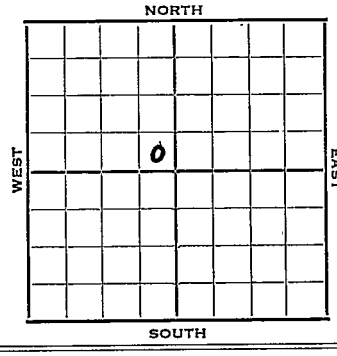

1952	REPORT
7/23	Cellar & Pits
7/30	"
8/6	"
8/13	Anhy 1802' Drlg. 3030'
8/20	Heeb 3410' Tor 3434' Lans 3451' DST 3480-97, 1 hr, 126' wtr 1340# DST 3526-35, 40 mins 200' wtr 1260# DST 3604-22, 1 hr, 75' SGMCO 1000# DST 3630-45, 1 hr, 28' M & SO 1190# B KC 3662' Arb. 3781-89' RTD 5" @ 3783'
8/27	CO 3753 Ran log 31/3635-42 bad cement job, sq off
9/3	15/3617-22 24/3616-24 500 A 1/2 BO & 1/2 Bwpd 1000 A 1 BO & 1 Bwph for 12 hrs. 3000 A no help 24/ 3605-11 1/2 BO & 1/2 BW sq. off.
9/10	DD 3790' B/12 Gal Oil & 10 gal WPH B/7 Gal Oil plus 3 gal WPH 500 A S/48 gal Oil plus 20 gal WPH
9/17	Sq off CO 3790' DD 3790½ 1500 A S/1/4 BFPH 500 A

OVER

1952

9/24 1000 A S/1 BOPH 2000 A S/1 BOPH

10/7 PB 3660 24/3642-45 wtr -
PB 3630 24/3618-24 wtr 500A
2 galo & 50 galwph 2000A

10/15 Spud 8-6-52
D&A TD 3790½'
8" @ 152
Anhy 1802 Heeb. 3410
Tor. 3434 Lans. 3451
DST 3480-97 open 1 hr. rec. 126' wtr. 1340#
DST 3526-35 open 40min. rec. 200' wtr. 1250#
DST 3604-22 open 1 hr. rec. 75' sgmco 1000 #
DST 3630-45 open 1 hr. rec. 28' mud 1190# BKC 3662 Arb. 3781
TD 3789 5" @ 3783 CO to 3753
21/ 3635-42 15/ 3617-22
24/ 3616-24 500 A ½ bo ½ bwpd 1000 A 1 bo 1 bwph 12 hr.
3000 A 24/ 3605-11 ½ bo ½ bw
DD 3790 B/ 12 go 10 gwph
B/ 7 go 3 gwph 500 A S/ 48 go 20 gwph CO to 3790 DD 3790½
1500 A S/ ¼ bfph 500 A 1000 A S/ 1 boph 2000 A S/ 1 boph
S/ ¼ boph PB 3660 24/ 3642-45 wtr. PB 3630 24/ 3618-24
S/ ¼ bwph 500 A S/ 2 go 50 gwph
2000 A S/ 3 bwph D&A

ABANDONED

FORM 275 FOR SALE BY KANSAS BLUE PRINT CO.


County Graham State Kansas

Sec. 33 (Blk. Twp.) 7 (Sur. Rge.) 22W Map No.

Operator D. G. Hansen

Well No. 1 Farm Morphew

Elev. Location SE SE NW

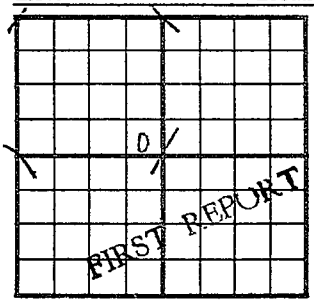

330 Ft. From S Line NW

330 Ft. From E Line Quarter

1st. Report JUL 23 1952

Completion

Remarks

C & G Drlg. - Contr.

Spudding Date

Drlg. Data Wildcat

Cellar & pits

J. G. McGEHEE

FORM 275 FOR SALE BY KANSAS BLUE PRINT CO.


County Graham State Kansas

Sec. 33 (Blk. Twp.) 7 (Sur. Rge.) 22W Map No.

Operator D. G. Hansen

Well No. 1 Farm Morphew

Elev. 2210 Location SE SE NW

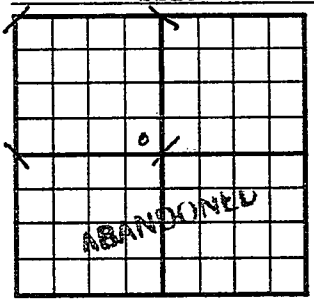

330 Ft. From S Line NW

330 Ft. From E Line Quarter

1st. Report

Completion OCT 1 5 1952

Remarks Wildcat

C & G Drlg. - Contr.

Spudding Date 8-6-52

Drlg. Data D & A TD 3790½

8" @ 152 Anhy 1802 Heeb. 3410

Tor. 3434 Lans. 3451 DST 3480-97

open 1 hr. Rec. 126' wtr. 1340#

DST 3526-35 open 40 min. Rec. 200' wtr.

1260# DST 3604-22 open 1 hr. Rec.

75' sgmco 1000 # DST 3630-45 open 1 hr.

Rec. 28' mud 1190# B KC 3662

Arb. 3781 TD 3789 5" @ 3783 CO to 3753

21/ 3635-42 15/ 3617-22 24/ 3616-24

500 A ½ bo ½ bwpd 1000 A 1 bo

1 bwph 12 hr. 3000 A 24/ 3605-11

½ bo ½ bw DD 3790 B/ 12 go 10 gwph

B/ 7 go 3 gwph 500 A S/ 48 go 20 gwph

CO to 3790 DD 3790½ 1500 A S/ ¼ bfph

J. G. McGEHEE

Drlg. Data


500 A 1000 A S/ 1 boph 2000 A

S/ 1 boph S/ $\frac{1}{4}$ boph PB 3660 24/ 3642-45

wtr. PB 3630 24/ 3618-24 S/ $\frac{1}{4}$ bwph

500 A S/ 2 go 50 gwph 2000 A

S/ 3 bwph

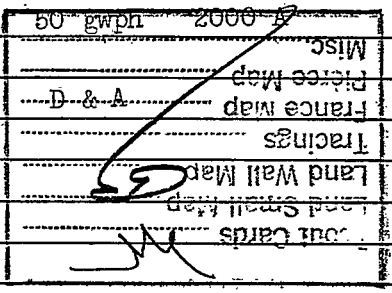

OCT 21 1952