

Section 33 Township 7 Range 22WWell No. #1 MorpheyCompany Nadel & Gussman

NORTH

D							

SOUTH

WEST

EAST

13

Graham

KANSAS

Sec. 33 Twp. 7 R. 22W

Well No. #1 Morpew Farm

Nadel & Gussman Company

Contractor


Ft. from N. Line

330 Ft. from S. Line

Ft. from E. Line

330 Ft. from W. Line

SW SW SW

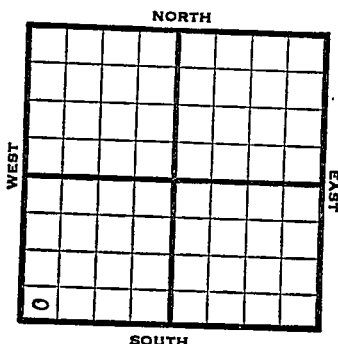

1952

Elev. 2185 REPORT

1/2

8" @ 168'

2/6

Heeb. 3381 Lans. 3421

B KC 3625 Arb. 3759

TD 3764 5" @ 3760 POP

2/13

1000 A Test 7 BOPH POP

2/20

POP

3/5

Spud 12-23-51

Oil Well TD 3795

8" @ 168 Heeb. 3381

Lans. 3421

DST 3446-65 opn 45 min. Rec. 180'

o & gcm 210' oil gcw

DST 3602-11 opn 1 hr. Rec. 7' mud

BKC 3625 Arb. 3759

TD 3764 5" @ 3760

CO to 3764 250 A Stratolift

S/15 bwph DD 3795 HFW

PB 3630 45/3600-09 500 A

B/1 bfph 20% wtr 1000 A

6 to 8 boph Comp. 273 bopd

8% wtr.

COMPLETED

County Graham State KansasSec. 33 (Blk. Twp.) 7 (Sur. Rge.) 22W Map No.Operator Nadel & GussmanWell No. 1 Farm MorphewElev. Location SW SW SW

0							

330 Ft. From S Line SW330 Ft. From W Line Quarter1st. Report JAN 2 1952

Completion


Remarks

Spudding Date

Drig. Data

8" @ 168

J. E. TYRA

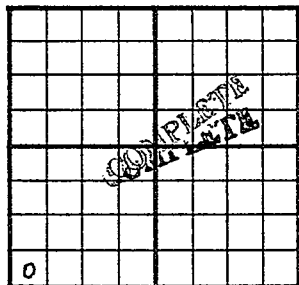County Graham State KansasSec. 33 (Blk. 7) (Sur. 22W) (Twp. 7) (Rge. 22W) Map No. Operator Nadel & GussmanWell No. 1 Farm MorphewElev. 2185 Location SW SW SW330 Ft. From S Line SW330 Ft. From W Line Quarter1st. Report Completion MAR 5 1952Remarks Spudding Date 12-23-51Drlg. Data Oil well TD 37958" @ 168 Heeb. 3381 Lans. 3421DST 3446-65 open 45 min. Rec. 180' o &gcm 210' oil & gcw DST 3602-11open 1 hr. Rec. 7' mud B KC 3625Arb. 3759 TD 3764 5" @ 3760CO to 3764 250' A Stratolift S/ 15 bwphDD 3795 HFW PB 3630' 45/ 3600-09500 A B/ 1 bfph 20% water 1000 A6 to 8 boph Comp. 273 bopd 8% water

J. G. McGEHEE