


Section 33 Township 7 Range 22W
Well No. #1 Worcester
Company D.G. Hansen

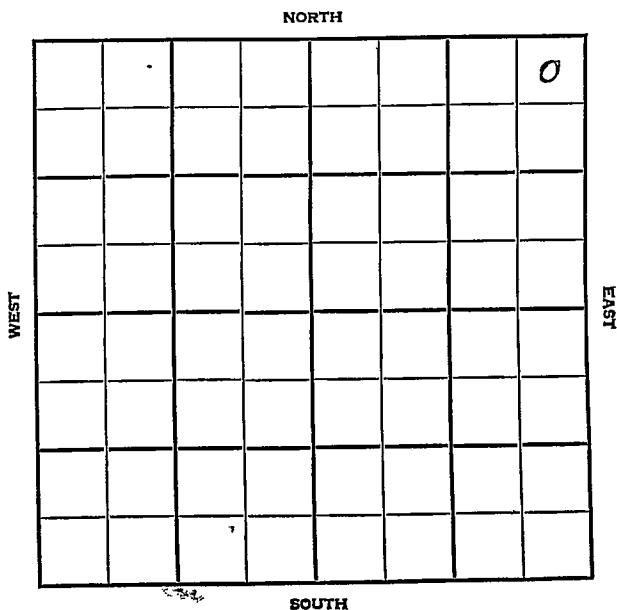

County Graham Elev. _____
 Sec. 33 Twp. (7) Rge. 22W
 Company D. G. Hansen
 Farm Name Worcester No. 1

TOPS	DEPTH	LOG	DATUM	Loc. in Sec.
Anb.	1801			NE NE NE
Tr.				
H.				
Tr.				
Dg.				
BL.				
L.				Geol.
K.C.				Contr.
B.K.C.				C.&G. Tools
Ce.				Pool
C.				Wildcat
M.				
M.				
K.				
Mz.				
Me.				
V.				
S.				
S.				
A				
R.				
Pe.				
G.				
T.D.				

Date Comm. 9-16-56

8" @ 200w/150 Drlg. 1901 SEP 26 '56

FIRST REPORT

Co.

Use.

No.

Sec.

T.

R.

County Graham Elev. 2215' KB
 Sec. 33 Twp. 7 Rge. 22W
 Company D. G. Hansen
 Farm Name Worcester No. 1

TOPS	DEPTH	LOG	DATUM	Loc. in Sec.
Anh.	1801			NE NE NE
Ip.				
H.	3410			
Tr.	3431			
Dg.				
Bl.				
L.	3449			Geol.
K.C.				Contr.
B.K.C.	3655			C.&G. Tools
Ce.				
C.	3761			
M.				
M.				Pool
K.				Wildcat
Mz.				
Mq.				
V.				
S.				
S.				
A	3828			
R.				
Pe.				
G.				
T.D.	3839			

Date Comm. 9-16-56

8" @ 200w/150 Drlg. 1901 SEP 26 '56

DST 3607-22 90" 160' GIP re
 20' oil + 40' Mdgy oil BHP 300
 DST 3624-42 1hr re 1' ocm
 BHP 0

D.E.A.

ABANDONE

SEP 26 '56