
FORM 51 10M 8-47

KANSAS Graham

Section 33 Township 7 Range 23W

Well No. #1 Spurling

Company Wilcox & B & B

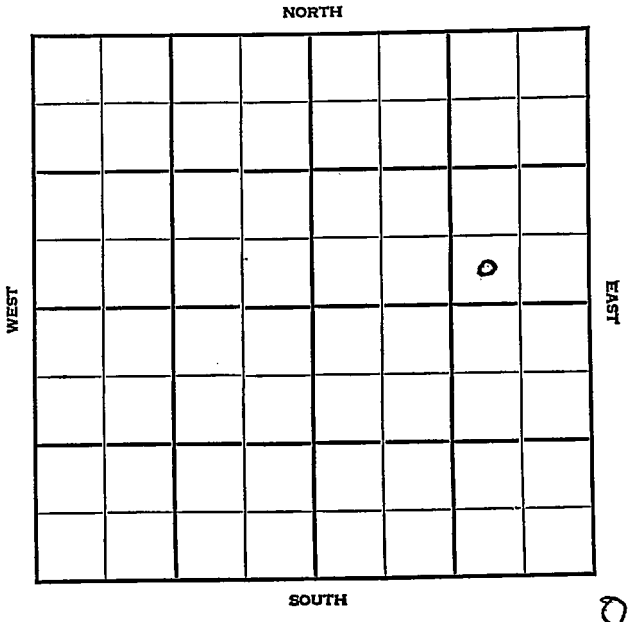

8

FORM 252-A
5M 4-48 PETROL

KANSAS Graham ✓

Sec. 33 Twp. 7 R. 23W

Well No. #1 Spurling Farm

Wilcox & B&R Company

Wildcat


_____ Ft. from N. Line

330' Ft. from S. Line

990' Ft. from E. Line

_____ Ft. from W. Line

SW SE NE

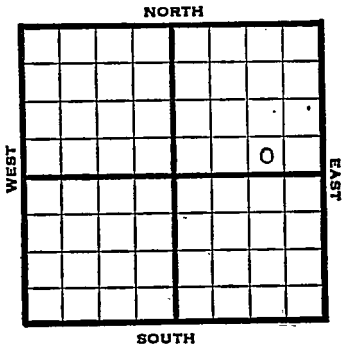

1948	Elev. 2365' REPORT
5/19	Location
5/26	8" @ 180' Drlg. 742'
6/1	Lansing 3647' Drlg. 3665'
6/12	5" set at 3900' Schl. tops Topeka 3409' Heebmer 3611' Lansing 3633' Bottom Kansas City 3861' Conglomerate 4018' Arbuckle 4044'-72' TD show of oil 3722'-36' Porosity no shows 3815-33' Show of oil 3830'-40' RUST. (Wire)
6/16	PB 3865' 30 shots 3830-38 1000 acid swb 24 gal W PH
6/23	TD 4072' Arb. 4044' Aband

ABANDONED

Form 26—200 Bks.—1-48—Palace

Wildcat

Kansas

Map No. _____ Sec. 33 Twp. 7 R. 23W


Well No. 1 Spurling

Wilcox & B & R Company

FIRST REPORT Contractor

SW SE NE

SECTION PLAT

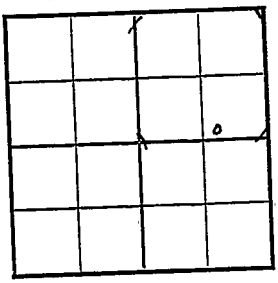

_____ Ft. from N. Line

330 Ft. from S. Line

990 Ft. from E. Line

_____ Ft. from W. Line

Graham County

Location x

Rig up

Drilling and Remarks:

RECORD

Cased _____ in., _____ ft.

Sand

Gas

Oil

Total Depth

PRODUCTION

1st 24 hrs. Nat.

1st 24 hrs. after shot

Gas _____ Cu. Ft.

Dry Hole

Abandoned

Date

MAY 19 1948 19_____ S. J. LEWIS Scout

Form 26—200 Bks.—1-48—Palace

Kansas

Map No. 66 Sec. 33 Twp. 7 R. 23W

Well No. 1 Spurling

Wilcox & B & R Company


ABANDONED

Contractor

SW SE NE

E. 2365

SECTION PLAT

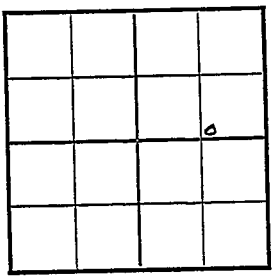

Ft. from N. Line

330 Ft. from S. Line

990 Ft. from E. Line

Ft. from W. Line

Graham County

Location

Rig up

Drilling and Remarks:

Cir 4044

RECORD

Cased in., ft.

Sand

Gas

Oil

Total Depth 4072

PRODUCTION

1st 24 hrs. Nat.

1st 24 hrs. after shot

Gas Cu. Ft.

Dry Hole

Abandoned

Date

JUN 23 1948 19 S. J. LEWIS Scout