
FORM 51 25M 8-50 WESTERN Graham KANSAS

Section 34 Township 7 Range 22W

Well No. #1 C. Jones

Company D. G.Hansen

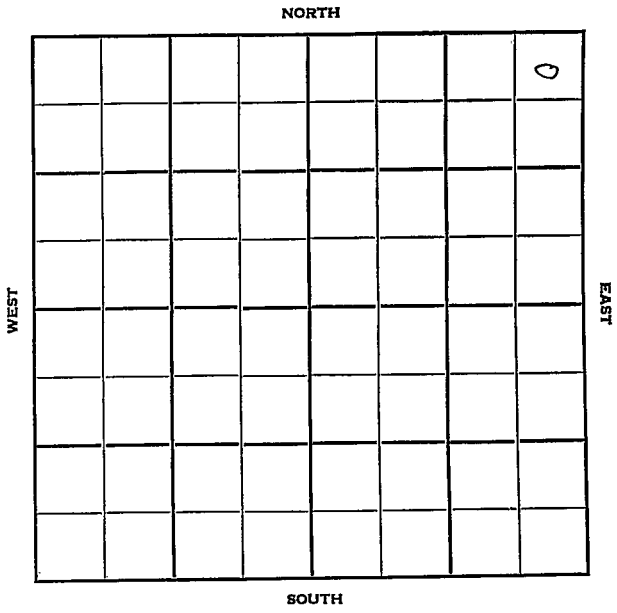

FORM 252-B
10M 10-50 PETROL

Graham

KANSAS ✓

Sec. 34 Twp. 7 R. 22W

Well No. #1 C. Jones Farm

D.G. Hansen Company

C & G Contractor

Wildcat


330 Ft. from N. Line

Ft. from S. Line

330 Ft. from E. Line

Ft. from W. Line

NE NE NE

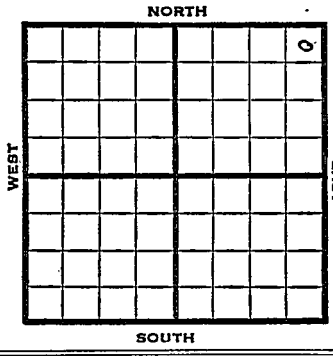

1952	Elev. 2168' REPORT
8/20	RU
8/27	8" @ 156' Anhy 1745 Drlg. 3372'
9/4	Spud 8-18-52 D&A TD 3763' 8" @ 156' Anhy 1745' Heeb. 3368 Tor. 3391 Lans. 3409 B KC 3609 Cong. 3728 Arb. 3754 TD 3763' D&A

ABANDONED

FORM 275 FOR SALE BY KANSAS BLUE PRINT CO.


County Graham State Kansas

Sec. 34 (Blk. Twp.) 7 (Sur. Rge.) 22W Map No.

Operator D. G. Hansen

Well No. 1 Farm C. Jones

Elev. Location NE NE NE

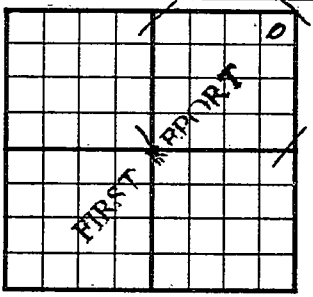

330 Ft. From N Line NE

330 Ft. From E Line Quarter

1st. Report AUG 20 1952

Completion

Remarks

C & G -Contr.

Spudding Date

Drlg. Data Wildcat

RU

J. G. McGEHEE

FORM 275 FOR SALE BY KANSAS BLUE PRINT CO.


County Graham State Kansas

Sec. 34 (Blk. Twp.) 7 (Sur. Rge.) 22W Map No.

Operator D. G. Hansen

Well No. 1 Farm C. Jones

Elev. 2168 Location NE NE NE

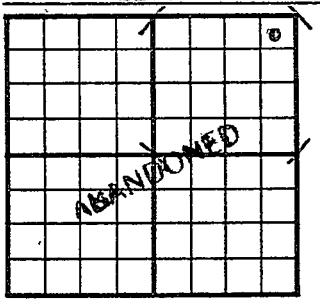

330 Ft. From N Line NE

330 Ft. From E Line Quarter

1st. Report

Completion SEP 4 1952

Remarks Wildcat

C & G Drlg. - Contr.

Spudding Date 8-18-52

Drlg. Data D & A TD 3763

8" @ 156 Anhy 1745 Heeb. 3368

Tor. 3391 Lans. 3409 B KC 3609

Cong. 3728 Arb. 3754 TD 3763

D & A

J. G. McGEHEE