
DX 78-1 Graham KANSAS

Section 34 Township 7 Range 23 W

Well No. #1 Dawson

Company Petroleum Inc.

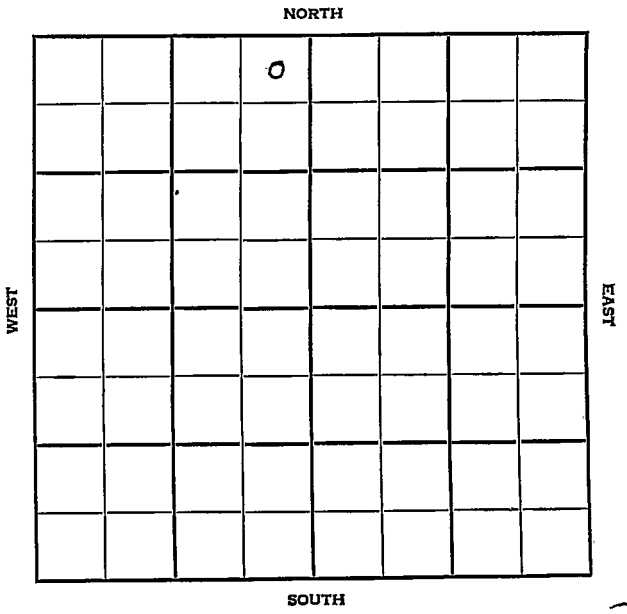

3

HOT FILE Graham KANSAS

SEC.	TWP.	R.
34	7	23 W

WELL NO. # 1 Dawson FARM

COMPANY Petroleum Inc.

CONTRACTOR Co. tools


Wildcat

_____ Ft. from N. Line

_____ Ft. from S. Line

_____ Ft. from E. Line

_____ Ft. from W. Line

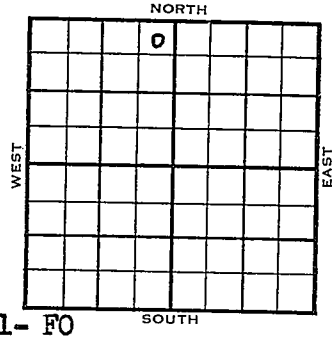

NE NE NW
SDX Lse 1/2 Mile

Shell- FO
Skelly & Shell - DHM

1955	ELEVATION 2362' REPORT
9/7	Comm. 9-4-55 8" @ 202/200 WOC
9-8	Spud 9-4-55 8" @ 202/200, WOC
9-15	Top 3379', Heeb. 3595, Tor. 3618, Lans. 3635 DST 3686-3721, open 1 hr.,rec. 210' wm, DST 3797-3825, open 1 hr., rec. 7'mud 820/20", ~~xxxx~~ Drlg. 3898
9-21	Log D & A

Tops	Depth	Log
Tp.	3379	
H.	3595	3593
Tr	3618	3617
L.	3635	3633
C.	3992	3989
A	4018	4019

TD 4068'

ABANDONED

DX-78

FORM 513 REV. SUNRAY

County Graham Elev.

Sec. 31 Twp. 7 Rge. 23W

Company Petroleum Inc.

Farm Name Dawson No. 1


TOPS	DEPTH	LOG	DATUM
Anh.			
T.P.			
H.			
Tr.			
Dg.			
B.L.			
L.			
K.C.			
B.K.C.			
Ce.			
C.			
M.			
M.			
K.			
Mz.			
Mc.			
V.			
S.			
S.			
A			
R.			
P€.			
G.			
T.D.			

Loc. in Sec. NE NE NW

Geol.

Contr. Co. tools

Pool Wildcat

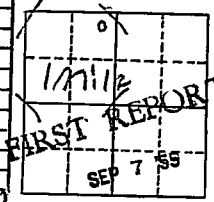

Date Comm. 9-4-55 Shell FO Skelly & Shell DHM

8⅝ @ 202/200 WOC

Co. Lse. No. Sec. T. R.

FORM 513 REV. SUNRAY

County Graham Elev. 2362

Sec. 34 Twp. 7S Rge. 23W

Company Petroleum, Inc.

Farm Name Dawson No. 1

TOPS	DEPTH	LOG	DATUM
Anh.			
Tp.	3379		1017
H.	3595	3593	1231
Tr.	3618	3617	1255
Dg.			
Bl.			
L.	3635	3633	1271
K.C.			
B.K.C.			
Ce.			
C.	3992	3989	1627
M.			
M.			
K.			
Mz.			
Mo.			
V.			
S.			
S.			
A	4018	4019	1657
R.			
Pe.			
G.			
T.D.	4068		

Loc. in Sec. NE NE NW

Geol.

Contr. Co. tools

Pool Wildcat

ABANDONED

Shell - FO

Shell & Skelly - DHC

SEP 2 1 1955

Date Comm. 9-4-55

8" 202 w/200; DST 3686-3721 op 1 hr. rec. 210' wm; DST 3797-3825 op 1 hr. rec. 7' mud, BHP 820# 20"; log; D & A

Co. Lse. No. Sec. T. R.