

First Ref

FORM 51 10M 2-49 PETROL

KANSAS

Rooks

Section 34 Township 7 Range 16-W

Well No. #1 Hardman

Company Stearns etal

Rooks County Wildcat

NORTH

WEST

EAST

						OK	

SOUTH

KANSAS

Rooks ✓

Sec. 34 Twp. 7 R. 16W

Well No. 1 Hardman Farm

Stearns et al Company

Wildcat Contr. Stearns Drlg. NORTH


330 Ft. from N. Line

Ft. from S. Line

990

330 Ft. from E. Line

Ft. from W. Line

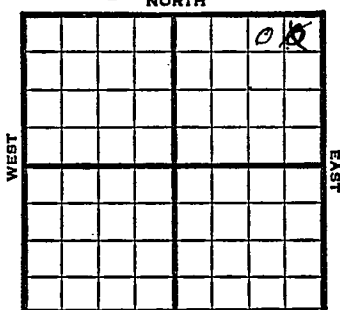

~~NE/6~~ NW NE NE

1949

Elev 1880'

REPORT

8/24

RUR

8/31

8" @ 228'

9/7

Drig. 2870'

9/14

TD 3515'

Lansing 3029'

Cong 3477'

Arb. 3499'

Aband.

ABANDONED

Map No. _____ Sec. 34 Twp. 7 R. 16W

Well No. 1 Hardman

Stearns etal. Company

Stearns Drlg. Contractor

NE/C


**FIRST REPORT
SECTION PLAT**

330 Ft. from N. Line

_____ Ft. from S. Line

330 Ft. from E. Line

_____ Ft. from W. Line

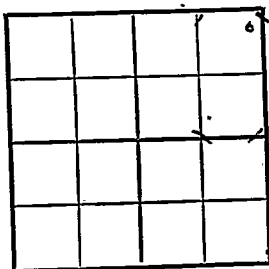

Rooks County

Location _____

Rig up _____

Drilling and Remarks:

R U R

RECORD

Cased _____ in., _____ ft.

Sand _____

Gas _____

Oil _____

Total Depth _____

PRODUCTION

1st 24 hrs. Nat. _____

1st 24 hrs. after shot _____

Gas _____ Cu. Ft.

Dry Hole _____

Abandoned _____

Date

AUG 24 1949 19

S. J. LEWIS Scout

Map No. _____ Sec. 34 Twp. 7 R. 16W

Well No. 1 Hardman

Stearns et al. Company

CORRECTION

Contractor

NW NE NE

SECTION PLAT

330 Ft. from N. Line

_____ Ft. from S. Line

990 Ft. from E. Line

_____ Ft. from W. Line

			0

Rooks County

Location _____

Rig up _____

Drilling and Remarks:

Reported

NE/C

RECORD

Cased _____ in., _____ ft.

Sand _____

Gas _____

Oil _____

Total Depth _____

PRODUCTION

1st 24 hrs. Nat. _____

1st 24 hrs. after shot _____

Gas _____ Cu. Ft.

Dry Hole _____

Abandoned _____

Date

AUG 31 1949 19

S. J. LEWIS

Scout

Map No. K64 Sec. 34 Twp. 7 R. 16W

Well No. 1 Hardman

Stearns et al.

Company

ABANDONED

Contractor

NW NE NE

E. 1980
SECTION PLAT

330 Ft. from N. Line

- Ft. from S. Line

990 Ft. from E. Line

- Ft. from W. Line

			0

Rooks County

Location

Rig up

Drilling and Remarks:

Line 3029

Cong 3477

Cut 3499

RECORD

Cased _____ in., _____ ft.

Sand _____

Gas _____

Oil _____

Total Depth 3515

PRODUCTION






Date

SEP 14 1949

S. J. LEWIS Scout