


Section 35 Township 7 Range 26W

Well No. #1 C.A. Groffort


Company Continental

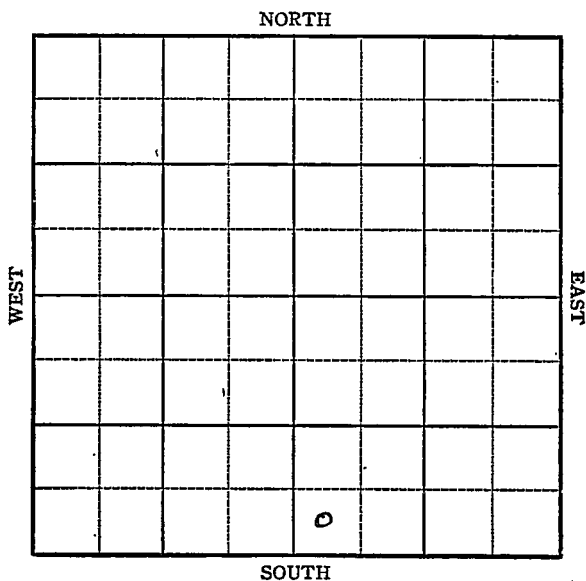

15

Sec. 35 Twp. 7 R. 26-WWell No. #1 C. A. Croffort FarmContinental Company

SW SE

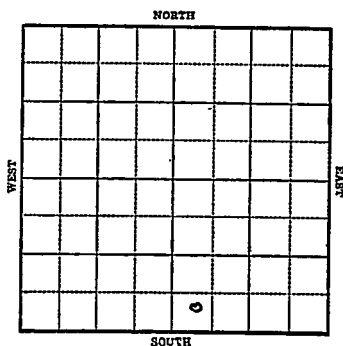 Ft. from N. Line440 Ft. from S. Line Ft. from E. Line330 Ft. from W. Line

1944

R E P O R T

1-26

3925' TD
5" at 3920'
Rust

2/2

Perf. 84 shots 3760-3874 no shows
to squeeze off perf.

2/8

PB 3765 to rip Csg.

2/16

Lans 3744
TD 3925
Water
D&A**ABANDONED**

KANSAS

Map No. 67 Sec. 35 Twp. 7 R. 26WWell No. 1 C. A. CroffortContinental


Company

FIRST REPORT

Contractor

SW SE

SECTION PLAT

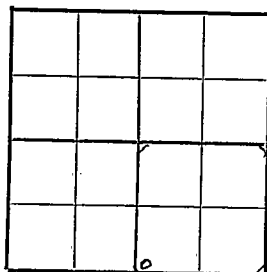

Ft. from N. Line

440

Ft. from S. Line

Ft. from E. Line

330

Ft. from W. Line

Wildcat

RECORD

Location

Cased _____ in., _____ ft.

Rig up

Sand _____

Drilling and Remarks:

Gas _____

3925 TD

Oil _____

5" - 3920 Rust

Total Depth _____

PRODUCTION

1st 24 hrs. Nat. _____

1st 24 hrs. after shot _____

Gas _____ Cu. Ft.

Dry Hole _____

Abandoned _____

Date

JAN 26 1944 19S. J. LEWIS Scout

KANSAS Sheridan

Map No. 67 Sec. 35 Twp. 7 R. 26WWell No. 1 C. A. CroffootContinental


Company

ABANDONED

Contractor

SW SE

SECTION PLAT

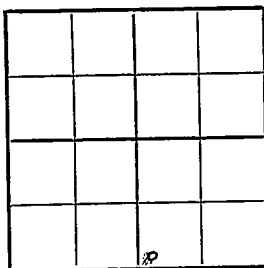 Ft. from N. Line440 Ft. from S. Line Ft. from E. Line330 Ft. from W. LineWildcatLocation Rig up

Drilling and Remarks:

lane 3244Water.DA

RECORD

Cased in., ft.Sand Gas Oil Total Depth 3925

PRODUCTION

1st 24 hrs. Nat. 1st 24 hrs. after shot Gas Cu. Ft.Dry Hole Abandoned

Date

FEB 16 1944 19S. J. LEWIS Scout