


SECTION 35 TOWNSHIP 7 RANGE 28W

WELL NO. #1 Stewart

COMPANY Empire Drlg.

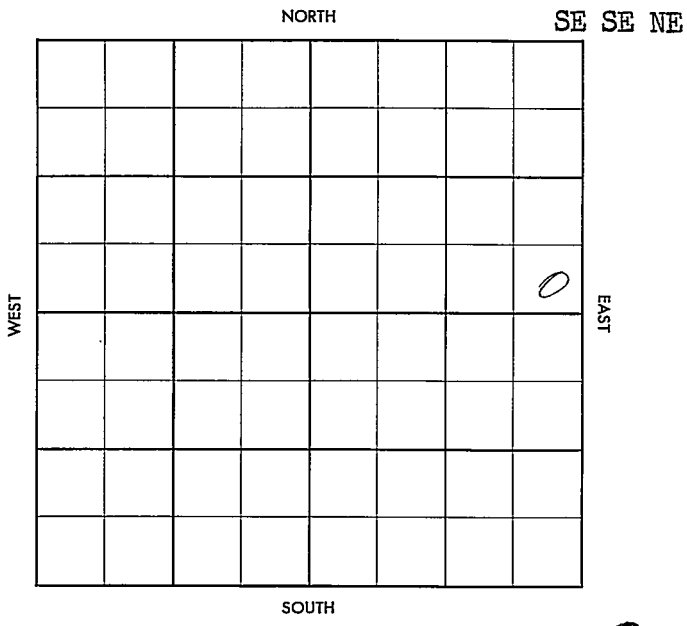

8

Sheridan

KANSAS

SEC.

35

TWP.

7 S

R.

28 W

WELL NO.

#1 Stewart

FARM

COMPANY

Empire Drlg.

CONTRACTOR

Co. tools

_____ FT. FROM N. LINE


_____ FT. FROM S. LINE

_____ FT. FROM E. LINE

_____ FT. FROM W. LINE

SE SE NE

SDX-1/2 Mile

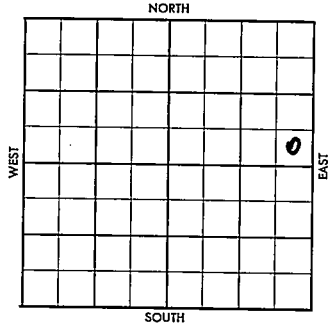

ELEVATION

1957

REPORT

5/15

Location

County Sheridan

Elev.

Sec. 35 Twp. 7

Rge. 28W

Company Empire Drlg.

FarmName Stewart

No. 1

Co.

TOPS	DEPTH	LOG	DATUM
Anh.			
Ip.			
H.			
Tr.			
Dg.			
Bl.			
L.			
K.C.			
B.K.C.			
Ce.			
C.			
M.			
M.			
K.			
Mz.			
Me.			
V.			
S.			
S.			
A.			
R.			
Pe.			
G.			
T.D.			

Loc. in Sec.

SE SE NE

Geol.

Contr.

Co. Tools

Pool

Sec.

FIRST REPORT

MAY 15 57

1/2 mile

No.

Sec.

T.

R.

Date Comm.

Location

~~33~~

