

KANSAS


Rooks

Section 35 Township 7 Range 17W

Well No. 3 Clayton

Company C R A et al

Stockton
NORTH

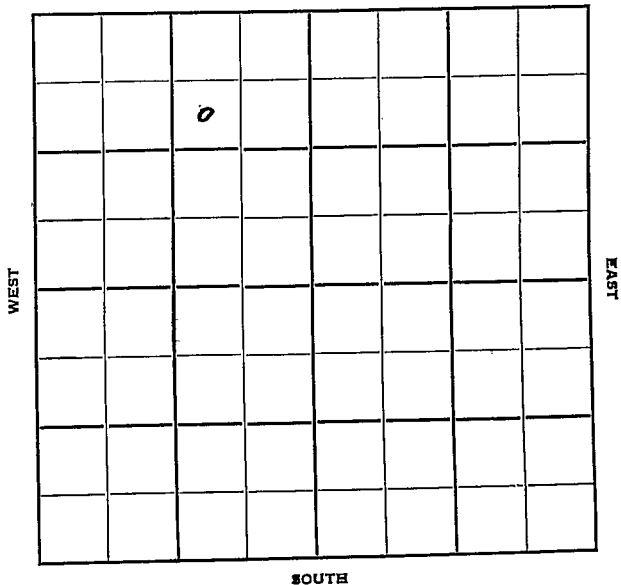

3

KANSAS

Rooks

Sec. 35 Twp. 7 R. 17W ✓

Well No. #3 Clayton Farm

C R A et al Company

Stockton Pool


990' Ft. from N. Line

_____ Ft. from S. Line

990' Ft. from E. Line

_____ Ft. from W. Line

SW NE NW

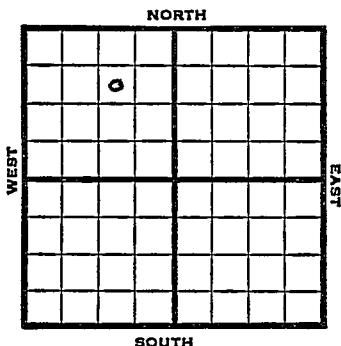

1949

Elev 1868' REPORT

4/13	RUR
4/20	8"@ 211'
4/27	Lansing 2971'
	TD 3028
	5"@ 3028'
5/4	24 shots 3006-18
	CO
5/10	1000 acid
	SW
	TD 3040'
5/18	"
5/25	Pump 8 bbls oil 24 hrs.
6/2	"
6/8	"
6/15	"
6/21	2500 acid
6/29	TD 3040'
	Lans 2971
	Top 2712'
	4"@ 3028'
	PB
	36 shots 2795-2810 wtr.
	Aband.

ABANDONED

Map No. _____ Sec. 35 Twp. 7 R. 17W

Well No. 3 Clayton

C R A etal. Company

FIRST REPORT Contractor

SW NE NW

SECTION PLAT

990 Ft. from N. Line

_____ Ft. from S. Line

990 Ft. from E. Line

_____ Ft. from W. Line

Rooks County

Location _____

Rig up _____

Drilling and Remarks: _____

R U R

RECORD

Cased _____ in., _____ ft.

Sand _____

Gas _____

Oil _____

Total Depth _____

PRODUCTION

1st 24 hrs. Nat. _____

1st 24 hrs. after shot _____

Gas _____ Cu. Ft.

Dry Hole _____

Abandoned _____

Date

APR 13 1949 19

S. J. LEWIS Scout

